


NOTICE OF MINING LOCATION

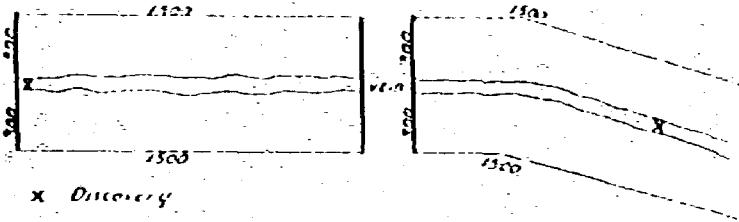

Washington State

Shamania County
(or Recording Precinct)
Mining District

NOTICE IS HEREBY GIVEN That the undersigned who is/are (have) declared a 11 intention as a citizen of the United States, have discovered and have located and claimed and do hereby locate 1500 linear feet in length, and 600 feet in width on the mine site and lode claim Firebird 16, Lode, vein, ledge or ~~deposited~~ ~~deposited~~ ground, situated in the above State, County (or Recording Precinct) and Mining District, and further described as follows: Commencing at a post marked No. 1 at the Discovery shaft (cut or tunnel), from thence 750 feet in a Southerly direction to an end post marked No. 2; thence 600 feet in a Easterly direction to a corner post marked No. 3; thence 750 feet in a Northly direction to a corner post marked No. 4; thence 750 feet in a Northly direction to a corner post marked No. 5; thence 600 feet in a Easterly direction to a corner post marked No. 6; thence 1500 feet in a Southerly direction to said end post No. 2; hereby locating and intending to claim 900000 square feet in a N.E., S. and W. direction from discovery to the deposite precious metals & minerals in pl. end line, and 600 feet in the opposite direction from discovery to the North to South end line and 300 feet on each side of the middle of said lode or ledge, for the purpose of mining the same and claiming all surface rights, privileges, and minerals, with all dips, spurs, angles and variations, and other rights granted by existing laws and customs.

This claim is further described by reference to natural objects or permanent monuments, as follows: Claim sits on Federal owned land in Alford Inchot National Forest, approximately 2 miles in a Northly direction on Forest service road 3031 to 621 from culvert on Firebird Land 2, Mile in a South Easterly direction on 621 to compass marker on Firebird No. 5. These claims run contiguous with each other. Appx taken 211 feet long. This notice is placed at Discovery on post No. 1; posts are placed at each corner, and the name of this lode, and date of location, are placed on all posts.

Located the 10 day of September 1991, By Edward M. Fire
Claim 116 in Section 15
Township 9 North, Range 9 East
W.M.

Edward M. Fire
George B. Lawry

WITNESSES:

Suggy Lawry

Edward Fire

Locators:

Oct 15 4 19 91

Suggy Lawry

Registered


Indexed, Dir

Indirect

Filmed 10/21/91

Mailed

Firebird mill site and lode claims no. 3, 4, 5, and 6 lie 2 miles in a Northwesterly direction on 9091 to 081 from culvert on Firebird 1 and 2 $\frac{1}{2}$ mile in a South Westerly direction on 081 to compass marker on Firebird No. 5 Section 15 Township 9 North, Range 9 East, S.M. In Skamania County, State of Washington, Gifford Pinchot National Forest. These claims are contiguous with each other. Appex taken on these claims in all direction. Edward H. Fire located claims on September 10, 1991.

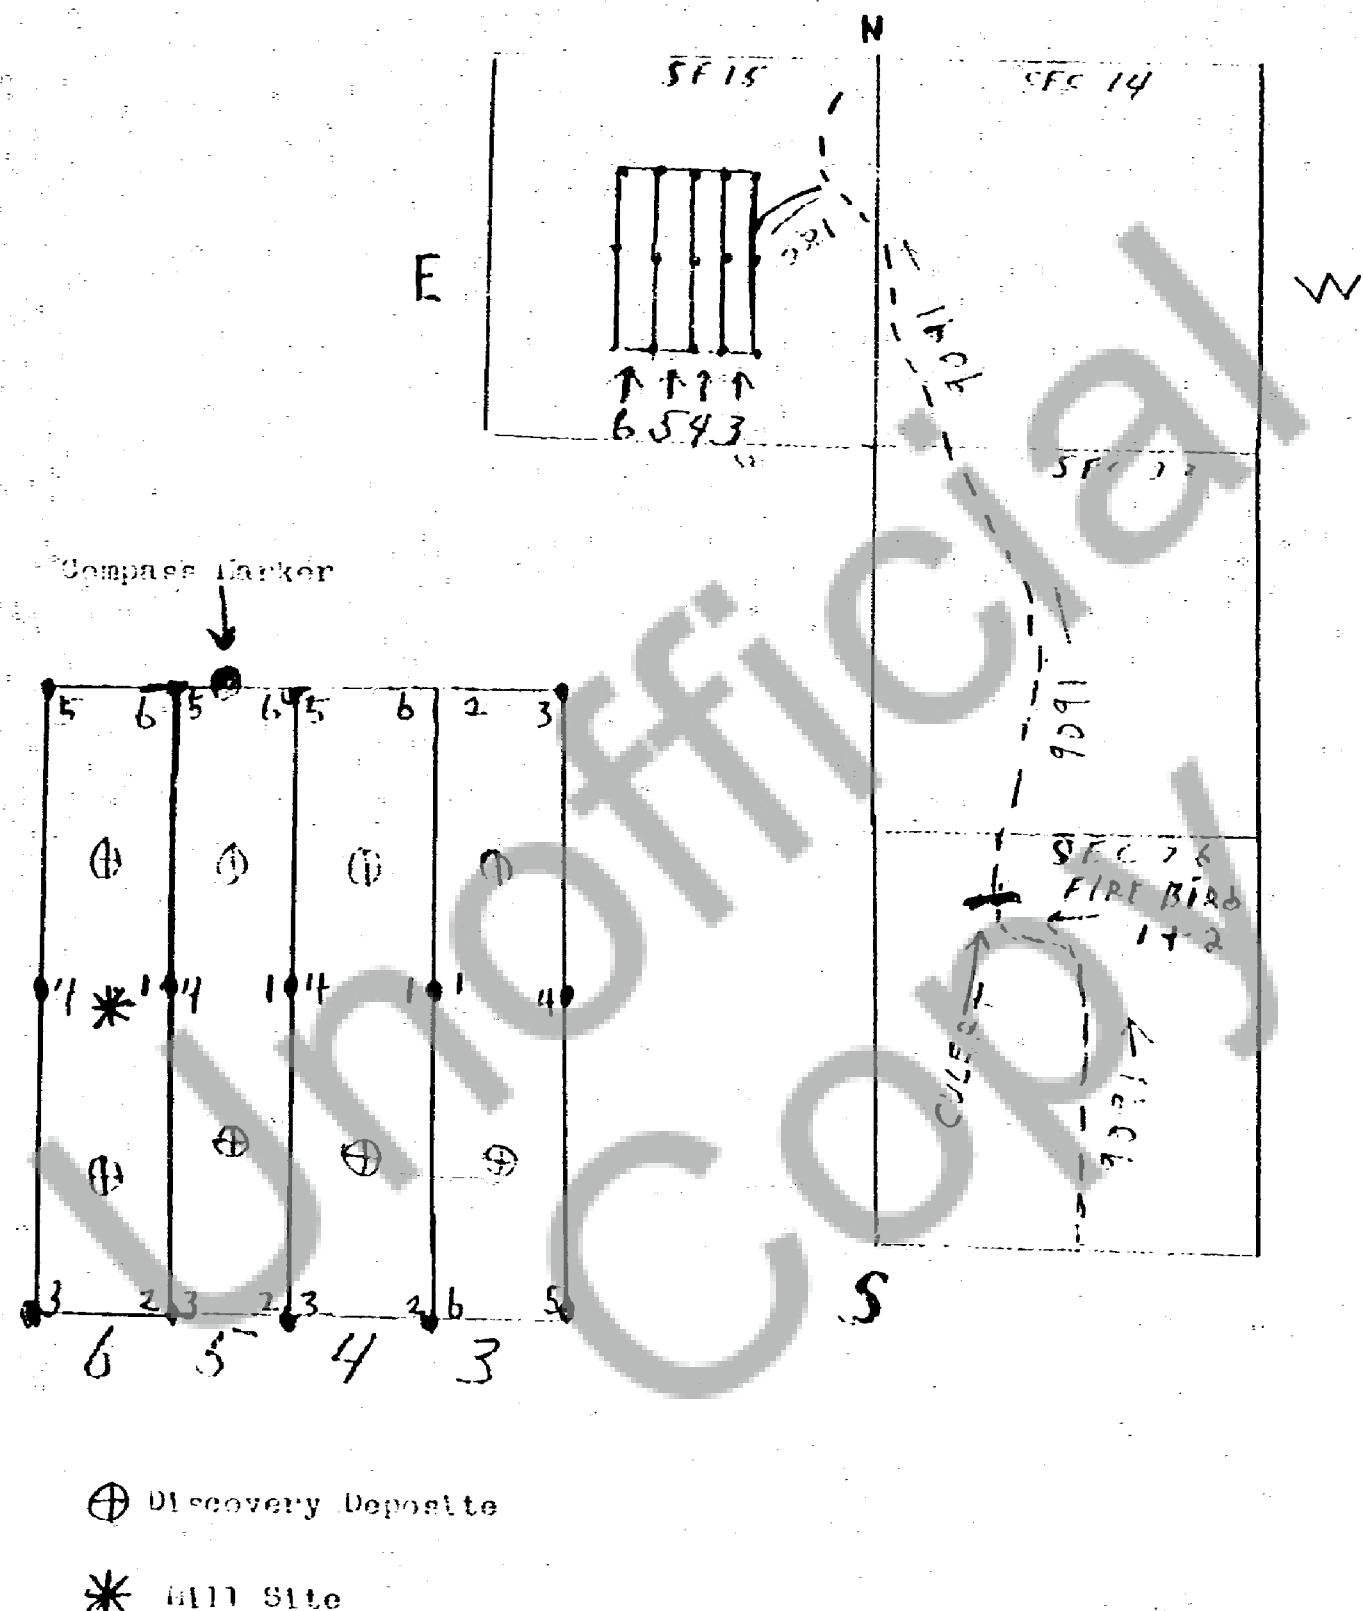

BOOK 125

PAGE 45 KEN

23

316

Ridge

4

Canyon

3

2

292

366

294

609

2328

294

Creek

637

3729

304

Council

653

Table

081

Boulder

4971

9051

14

16

Table

Mtn

049

TC

048

15

071

21

22

18

02

03

04

STEAMBOAT MTN I

1676 II NW

SCALE 1:24000

42°30'

600

402

401

603

604

• BUS G

