

114370

BOOK 130 PAGE 589

FILED FOR RECORD
SKAMANIA WASH
By Planning Dept.

SEP 4 4 53 PM '92

P. Olson

GARY M. OLSON

AFFIDAVIT

STATE OF WASHINGTON
County of Klickitat ^{SS}

Registered	<i>lp</i>
Indexed	<i>lp</i>
Indirect	
Filed	<i>9/29/92</i>
Mailed	

We, the undersigned, each being first duly sworn on oath, depose and say:

We have had an opportunity to examine the amended proposal to Short Plat recorded 12/17/90 in Volume 3, Pages 180-181 of the Plat Records, Skamania County, Washington and have no objections to the proposed amendment.

Rick D. Graves
RICK D. GRAVES

Jamie Graves
JAMIE GRAVES


Donald G. Struck
DONALD G. STRUCK


SUBSCRIBED and SWORN TO before me this 27th day of August, 1992.



Betty Lou Hunsaker
Notary Public in and for the
State of Washington


My Commission Expires: 1-10-93

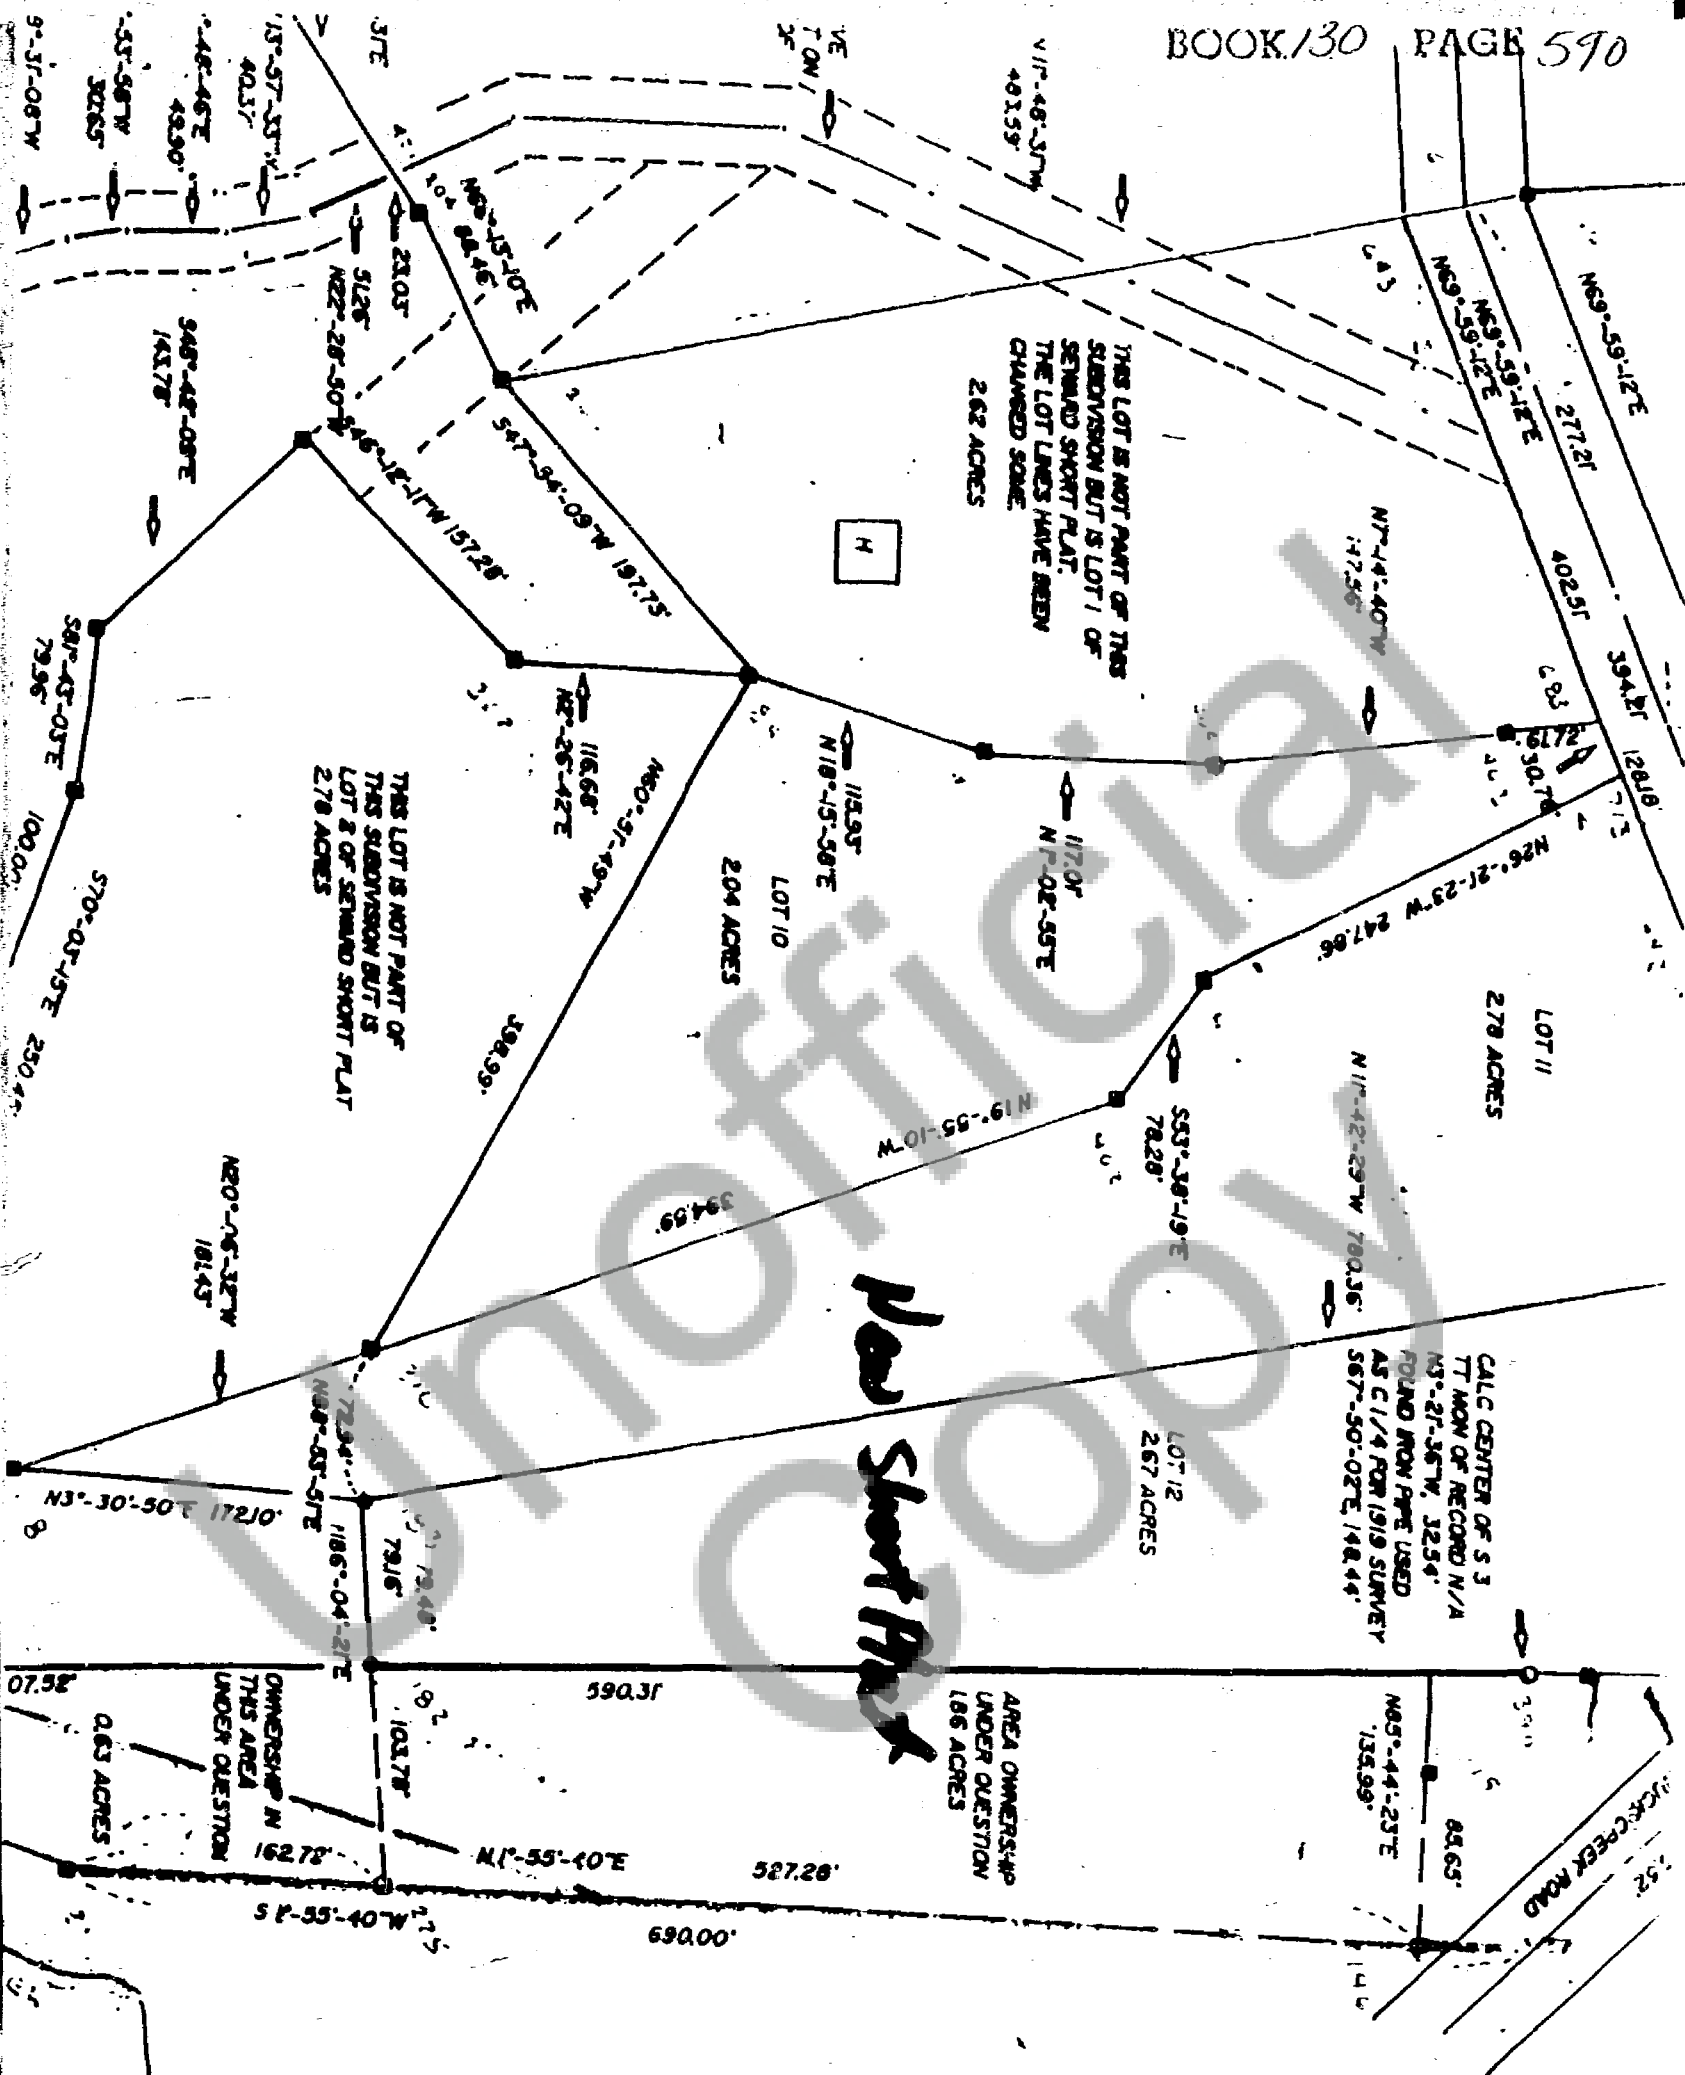

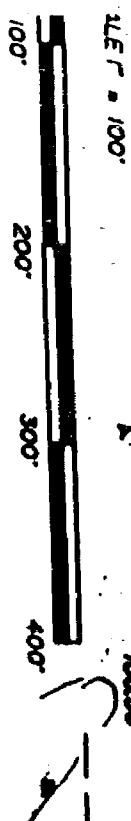

30\"/>

STATE:
THIS REPRESENTS A SURVEY MADE BY ME OR UNDER
MY CLOSE PERSONAL SUPERVISION AND IN ACCORDANCE WITH THE REQUIREMENTS OF THE SURVEY
AT THE REQUEST OF DUST MOSS IN AUG 1991

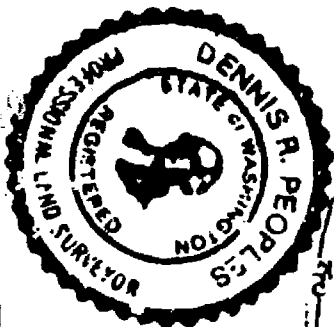

D2AB SURVEYING INC
22 COTTONTAIL RIDGE ROAD
WHITE SALMON, WA. 98672
PHONE NO. 493 3376


AUDITOR'S CERTIFICATE
FILED FOR RECORDING THIS


DAY OF

1994

IN BOOK OF PLATS
AT THE REQUEST OF D2AB SURVEYING INC.

COUNTY AUDITOR

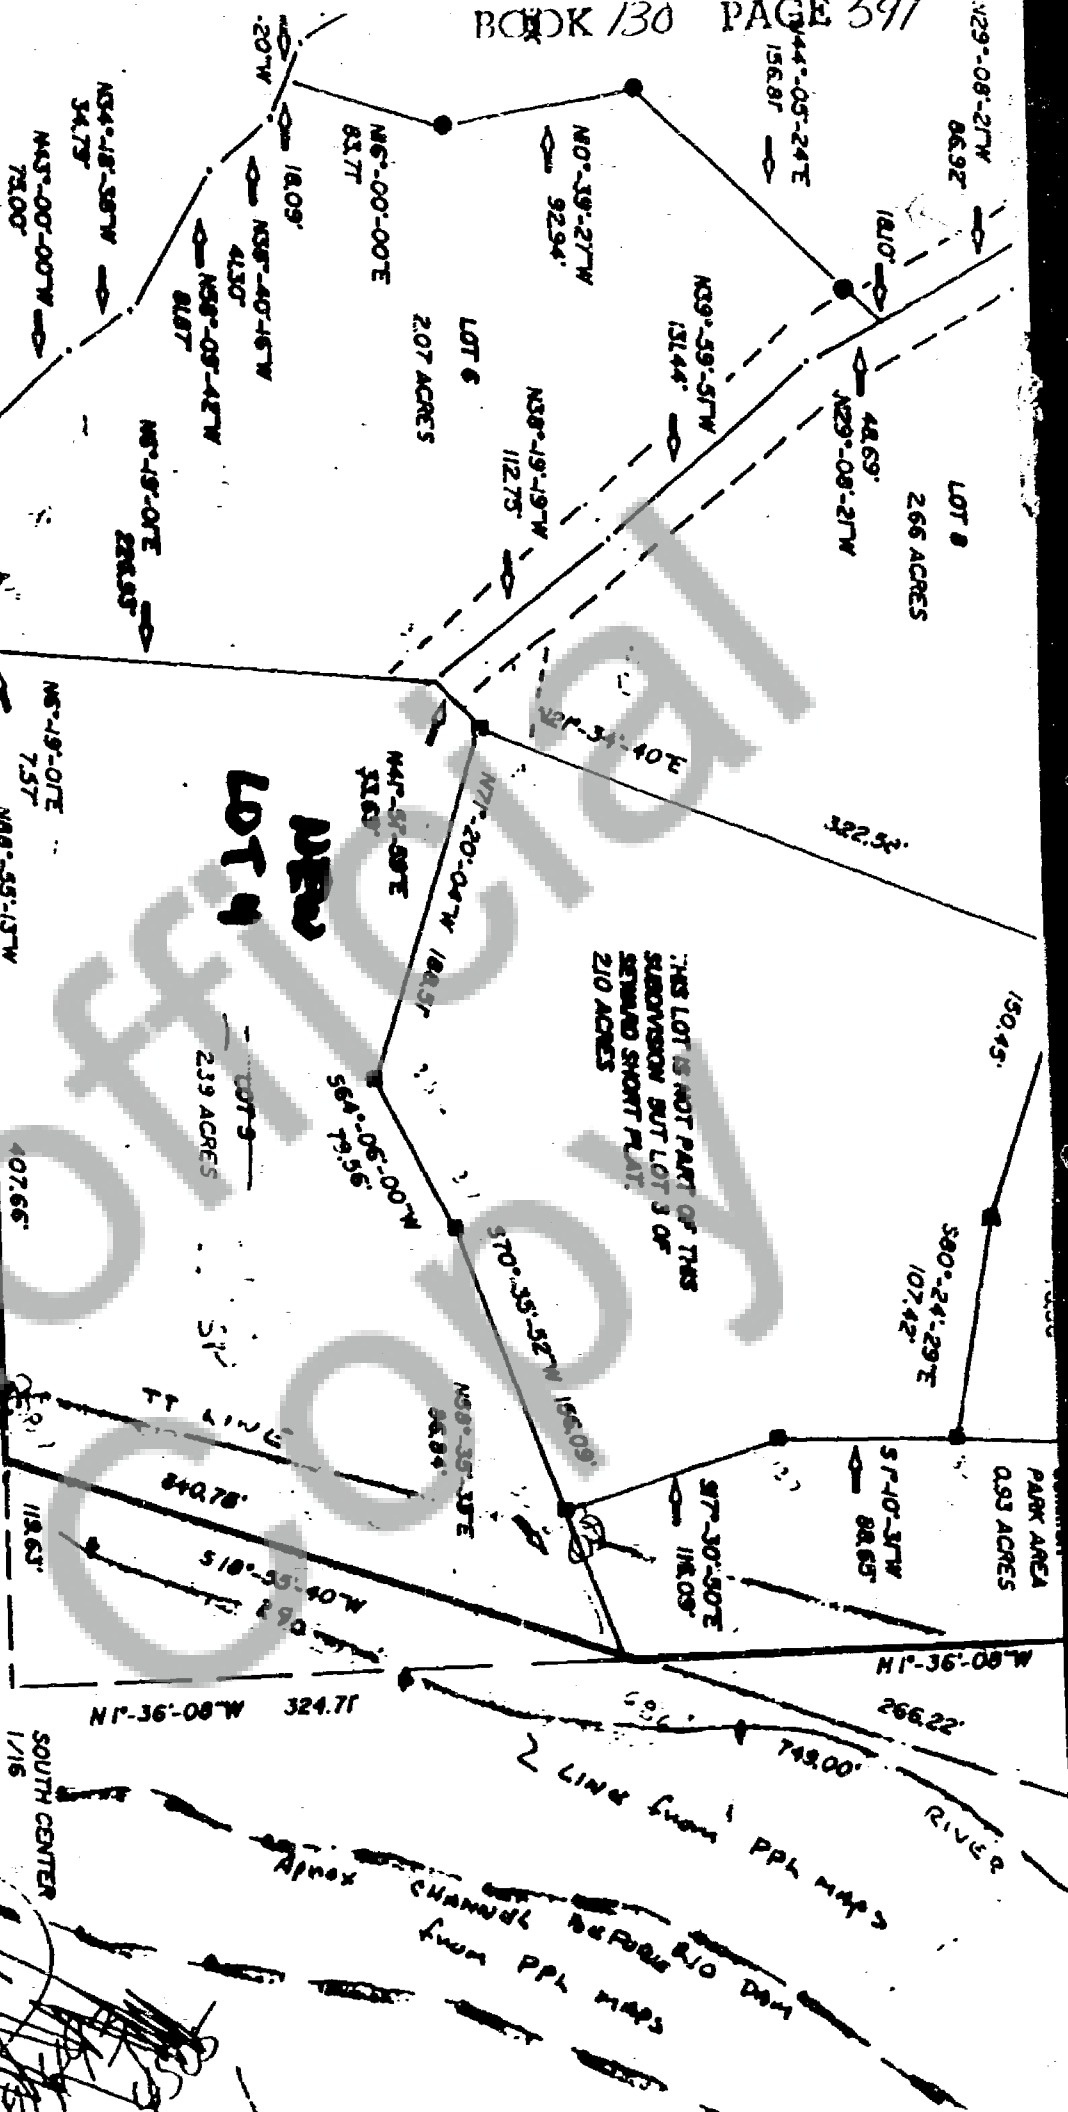

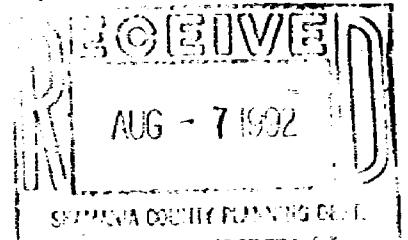

A F F I D A V I T

STATE OF OREGON)
 County of MULTNOMAH) SS


We, the undersigned, each being first duly sworn on oath, depose and say:

We have had an opportunity to examine the amended proposal to Short Plat ~~Map~~ Recorded 03/17/1990 in Vol. 5 p. 130-131 of 126 Pl. Records, Shastata County and have no objections to the proposed amendment (attached).

Don Oman
 DON OMAN

Alice Goldstein
 ALICE GOLDSTEIN

SUBSCRIBED and SWORN TO before me this 5th day of August, 1992.

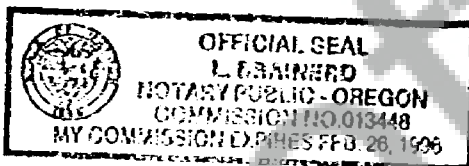


L. B. BARNERD
 Notary Public in and for the State of OREGON

My Commission Expires: 2/26/96


D2AB SURVEYING INC
22 COTTONTAIL RIDGE ROAD
WHITE SALMON, WA. 98672
PHONE NO. 493 3376


AUDITOR'S CERTIFICATE
FILED FOR RECORDS THIS _____ DAY OF _____ 1991
AT _____ IN BOOK _____ OF PLATS
AT THE REQUEST OF D2AB SURVEYING INC.
COUNTY AUDITOR

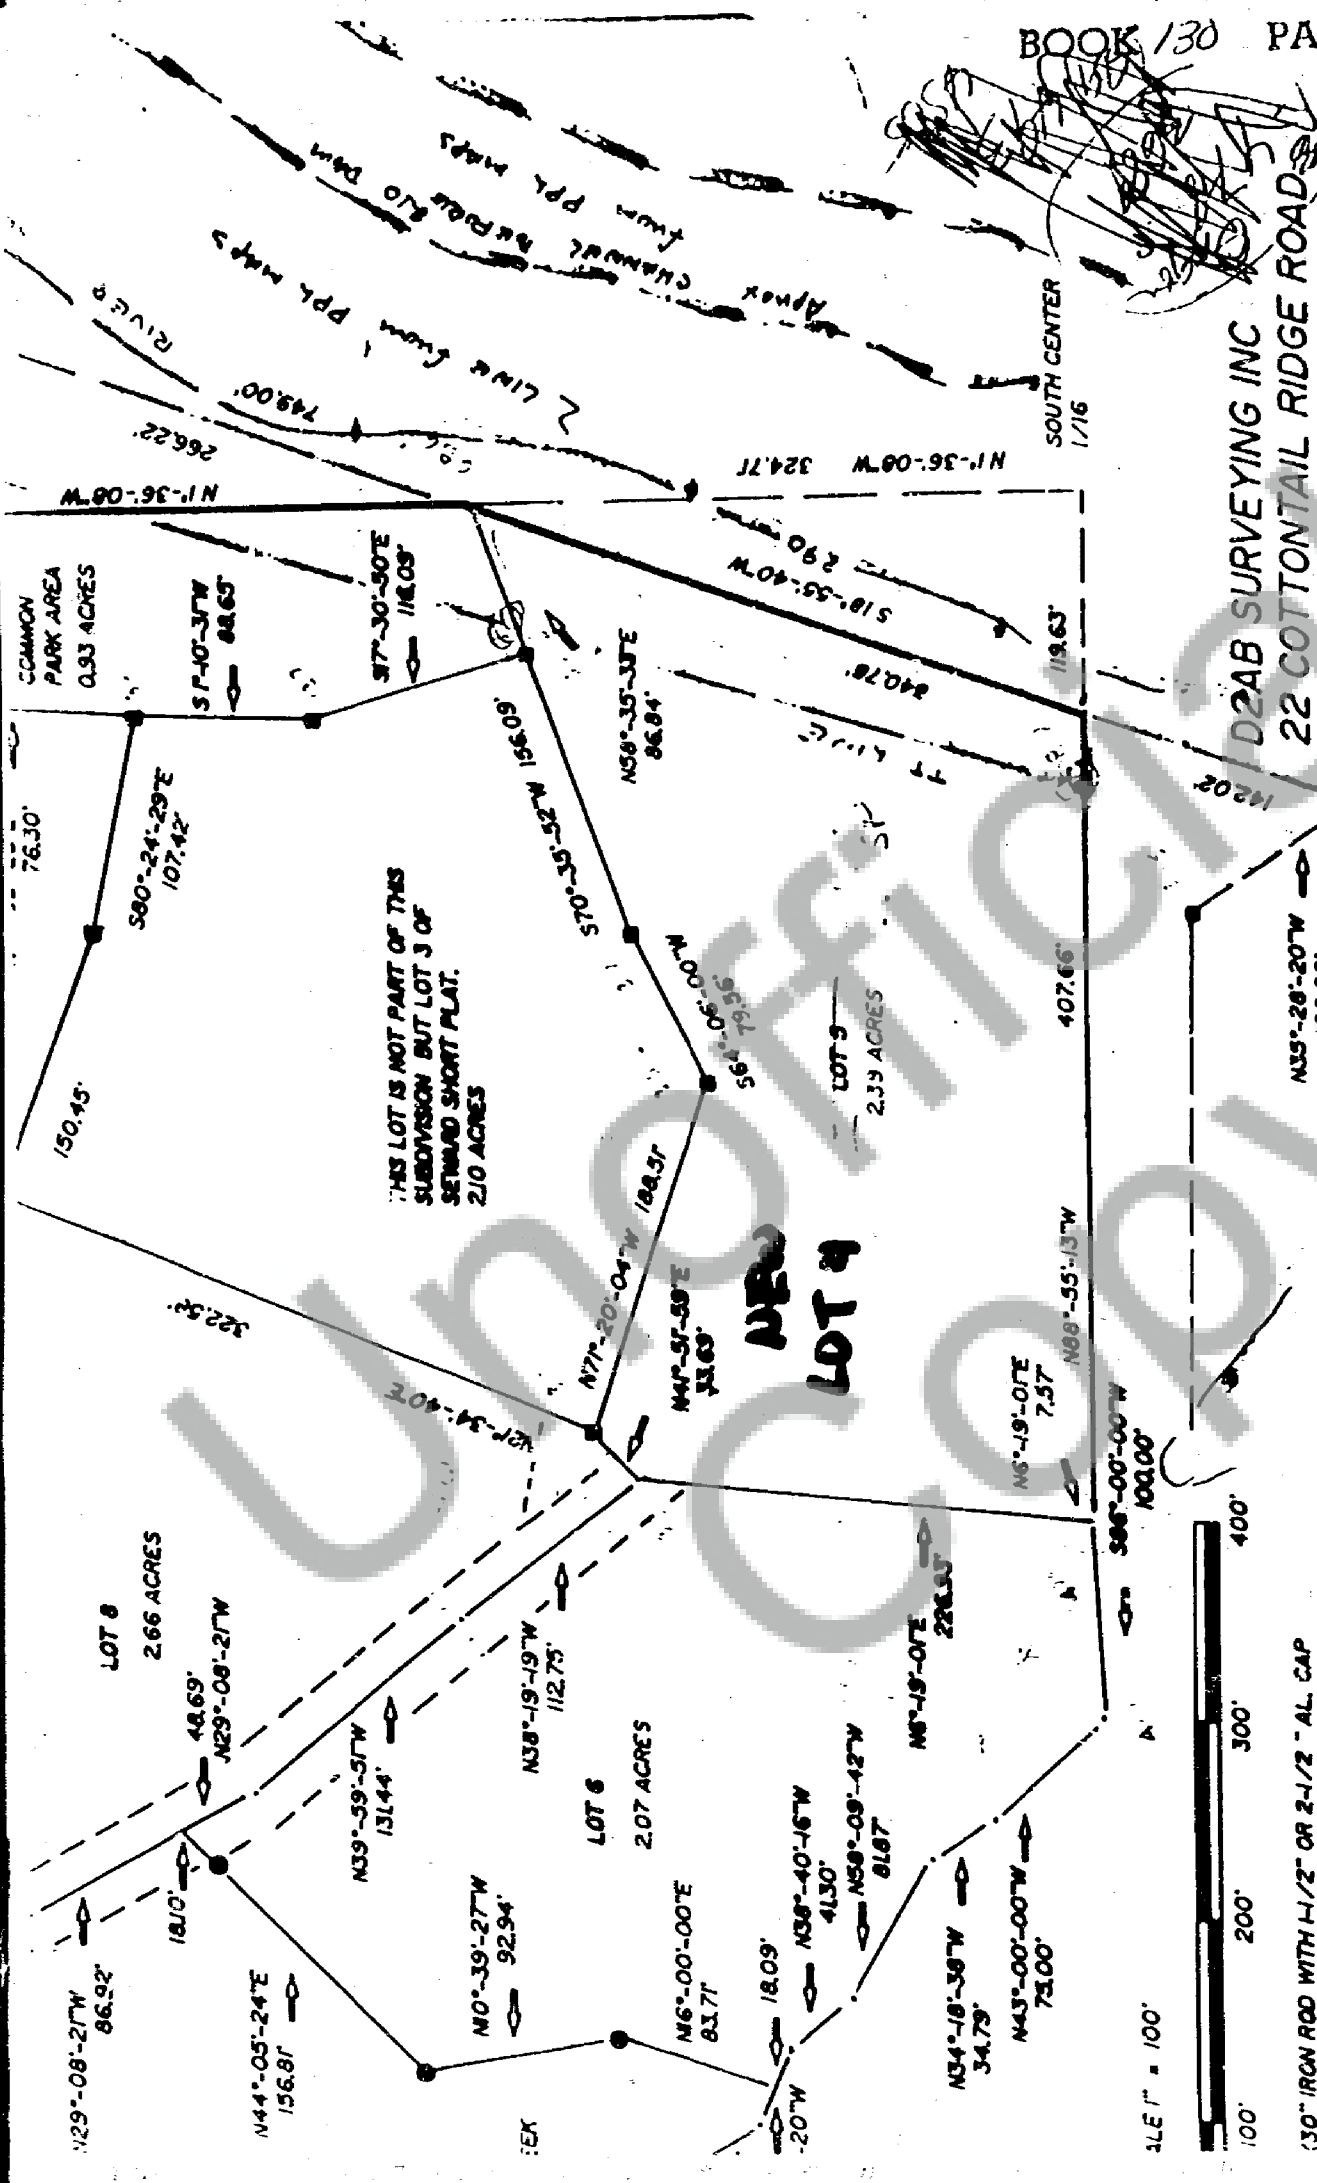

1" = 100'
100' 200' 300' 400'
1/2" IRON ROD WITH 1-1/2" OR 2-1/2" AL CAP
3/4" IRON PIPE OR A 7/8" X 30" IRON ROD WITH 2-1/2" BRASS OR AL CAP
EVIDENCE OF RECORD
ES FROM TIES NEAR CORNERS
TREES (SCRIBED) WITH NAIL APPROXIMATING THE CENTER
GLO BEARING TREE
ANCE OR ANOTHER SURVEYOR'S DISTANCE OR DEED CALL)

CERTIFICATE
RECTLY REPRESENTS A SURVEY MADE BY ME OR UNDER
CONFORMANCE WITH THE REQUIREMENTS OF THE SURVEY
AT THE REQUEST OF DUST MOSS IN AUG 1991

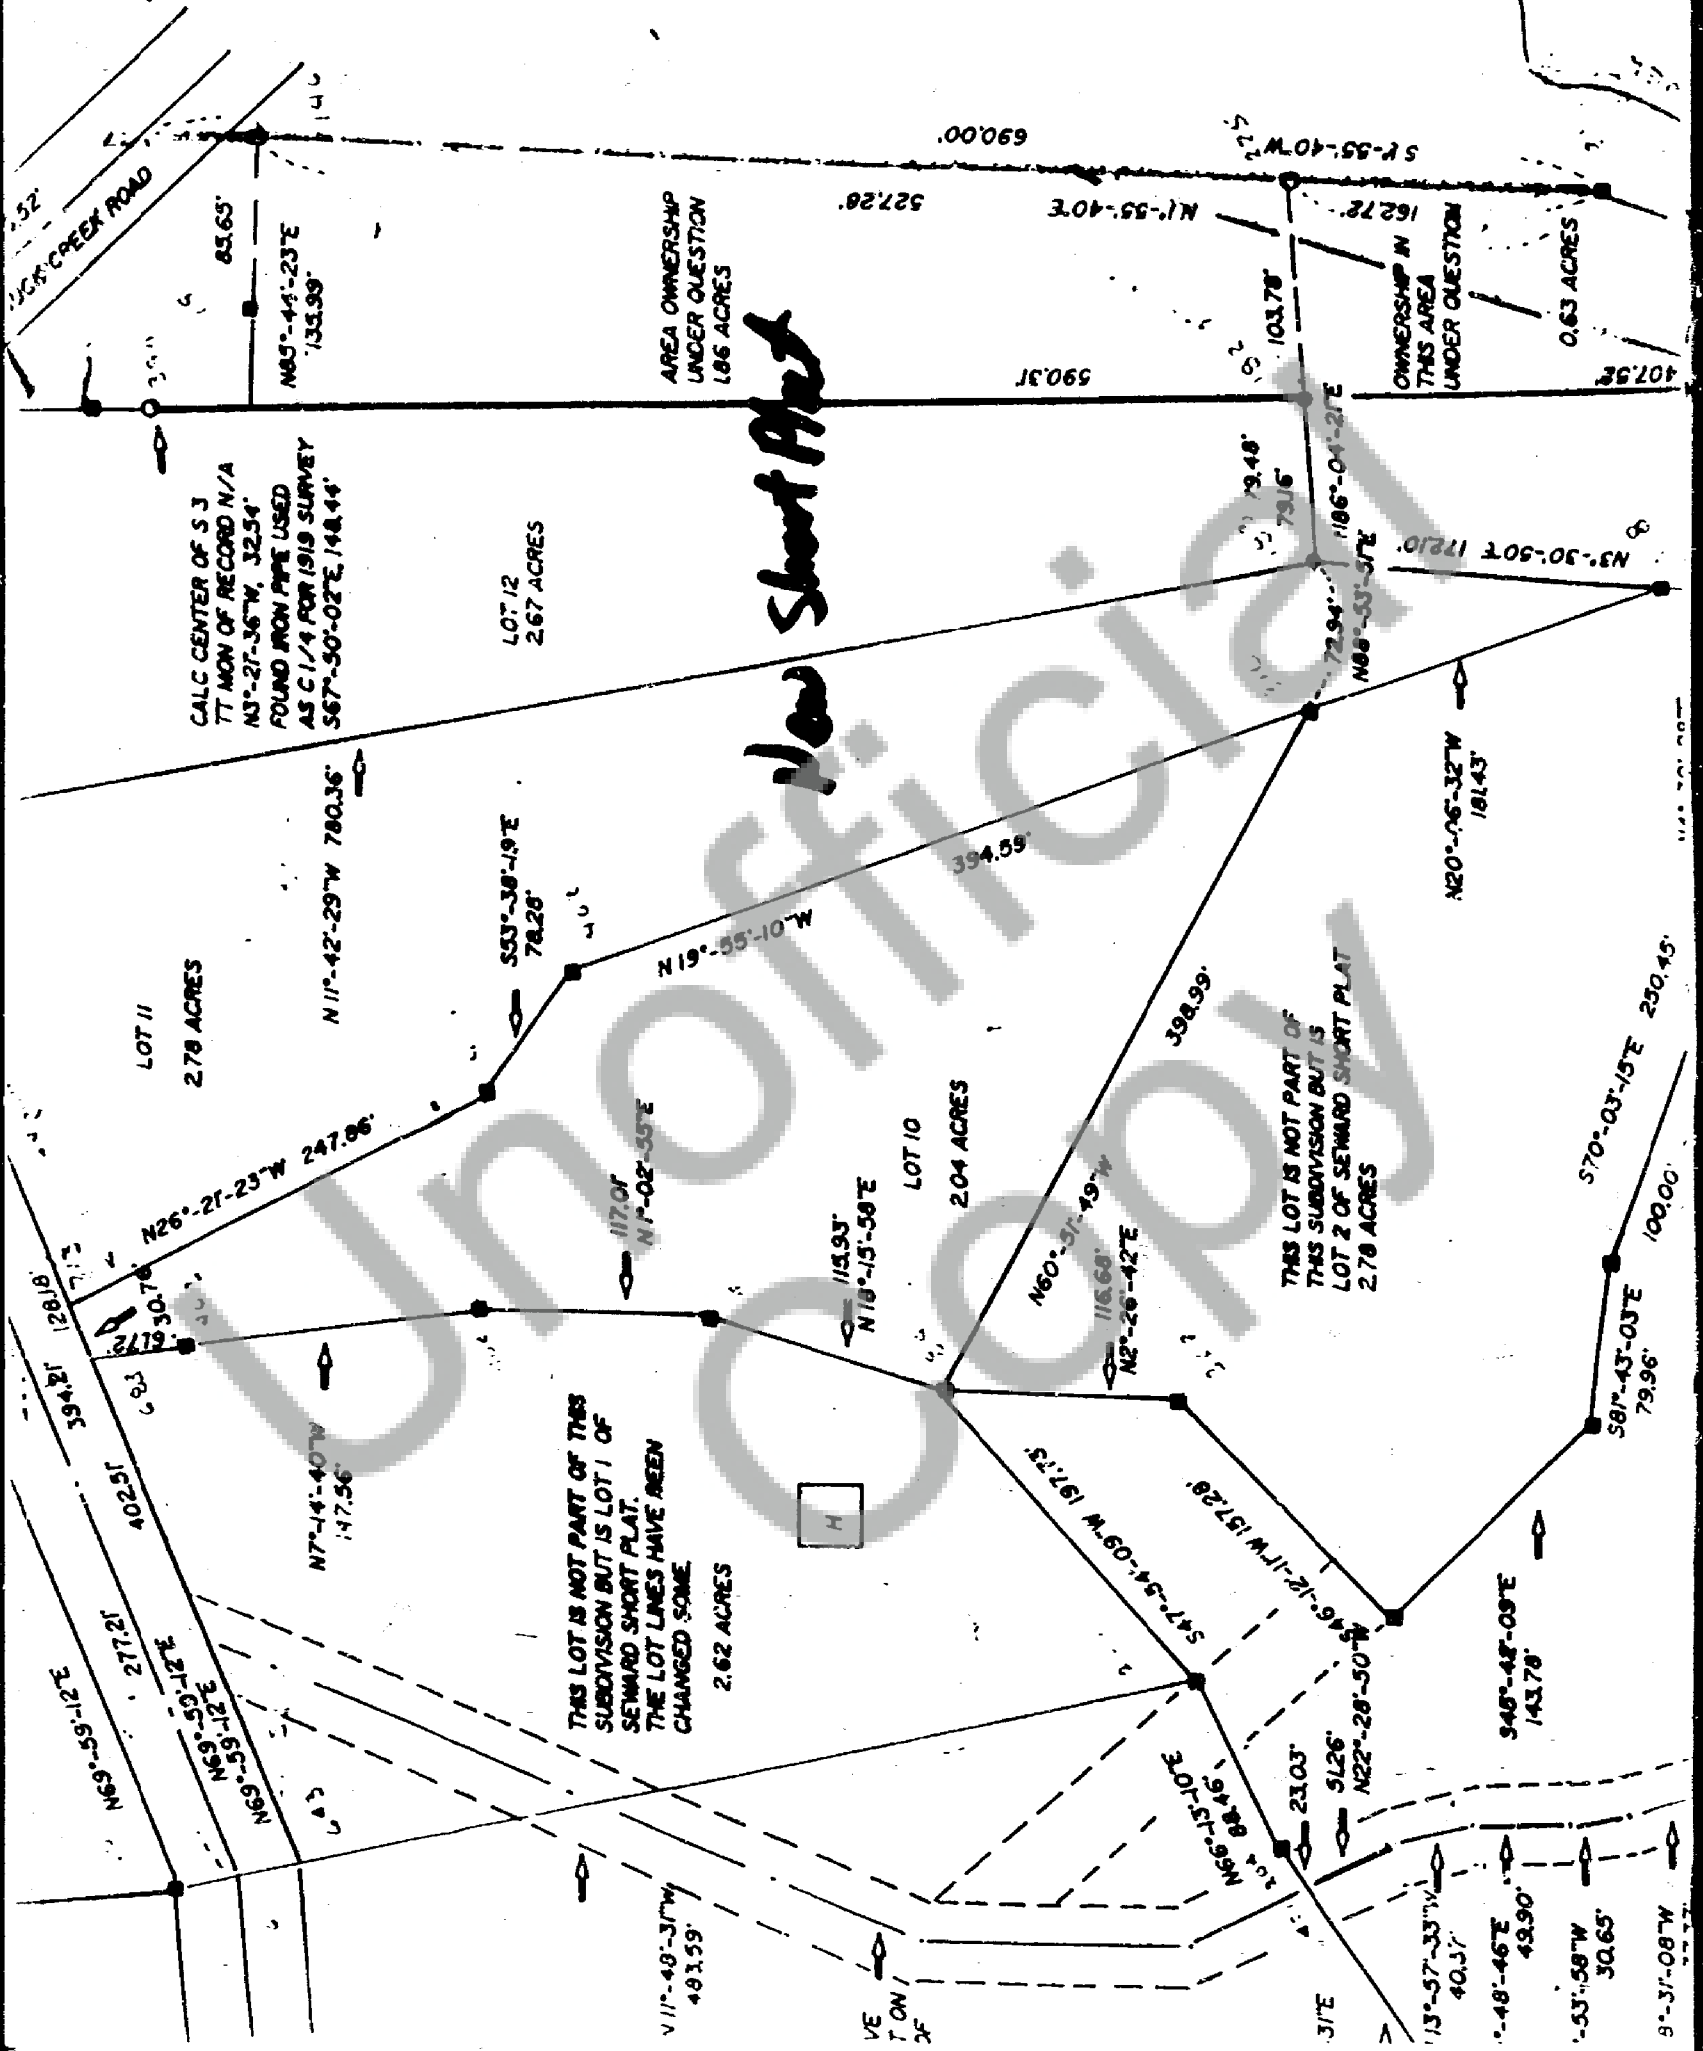

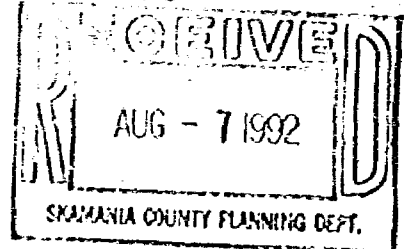

AFFIDAVIT

STATE OF GEORGIA)
 County of Clayton) ^{SS}

We, the undersigned, each being first duly sworn on oath, depose and say:

We have had an opportunity to examine the amended proposal to Short Plat ~~Record~~ Record 12/11/1990 and have no objections to the proposed amendment.
 Vol. 3, pp. 180-181 of the
 Plat Records, Skamania
 County,

Finley McIlhenney
 FINLEY MCILHENNEY


Montique McIlhenney
 MONTIQUE MCILHENNEY


SUBSCRIBED and SWORN TO before me this 15th day of July, 1992.

Sandra C. Gorday
 Notary Public in and for the
 State of GEORGIA


SANDRA C. GORDAY
 My Commission Expires: Notary Public, Clayton County, Georgia
 My Commission Expires Jan. 7, 1996



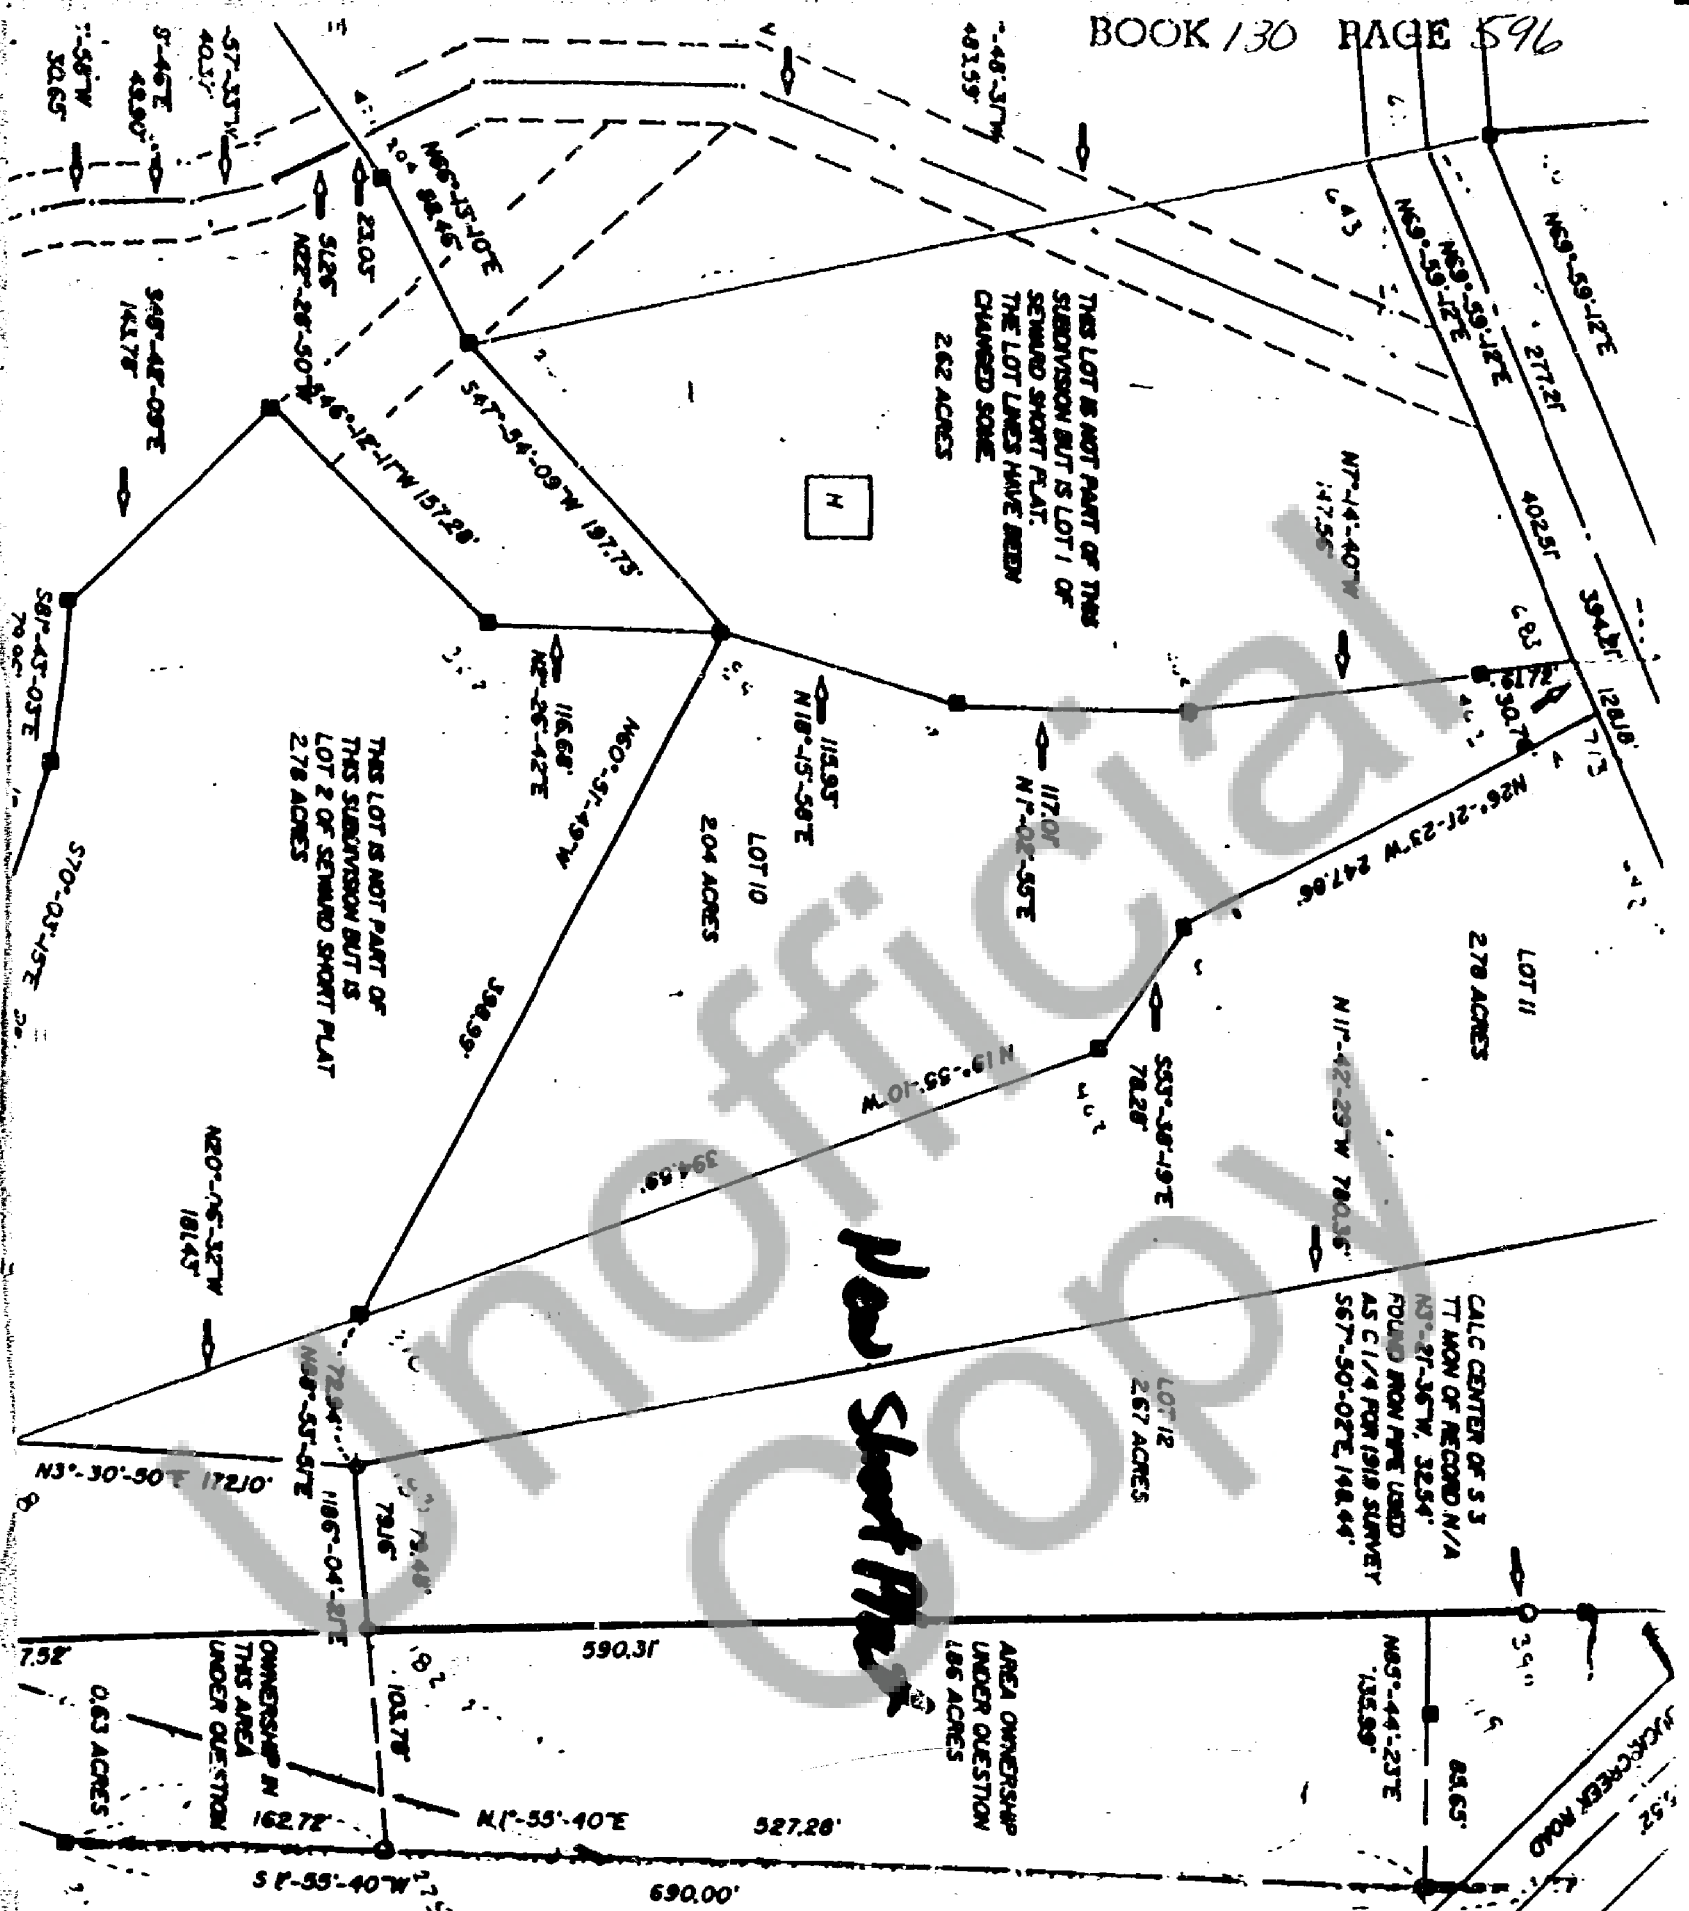

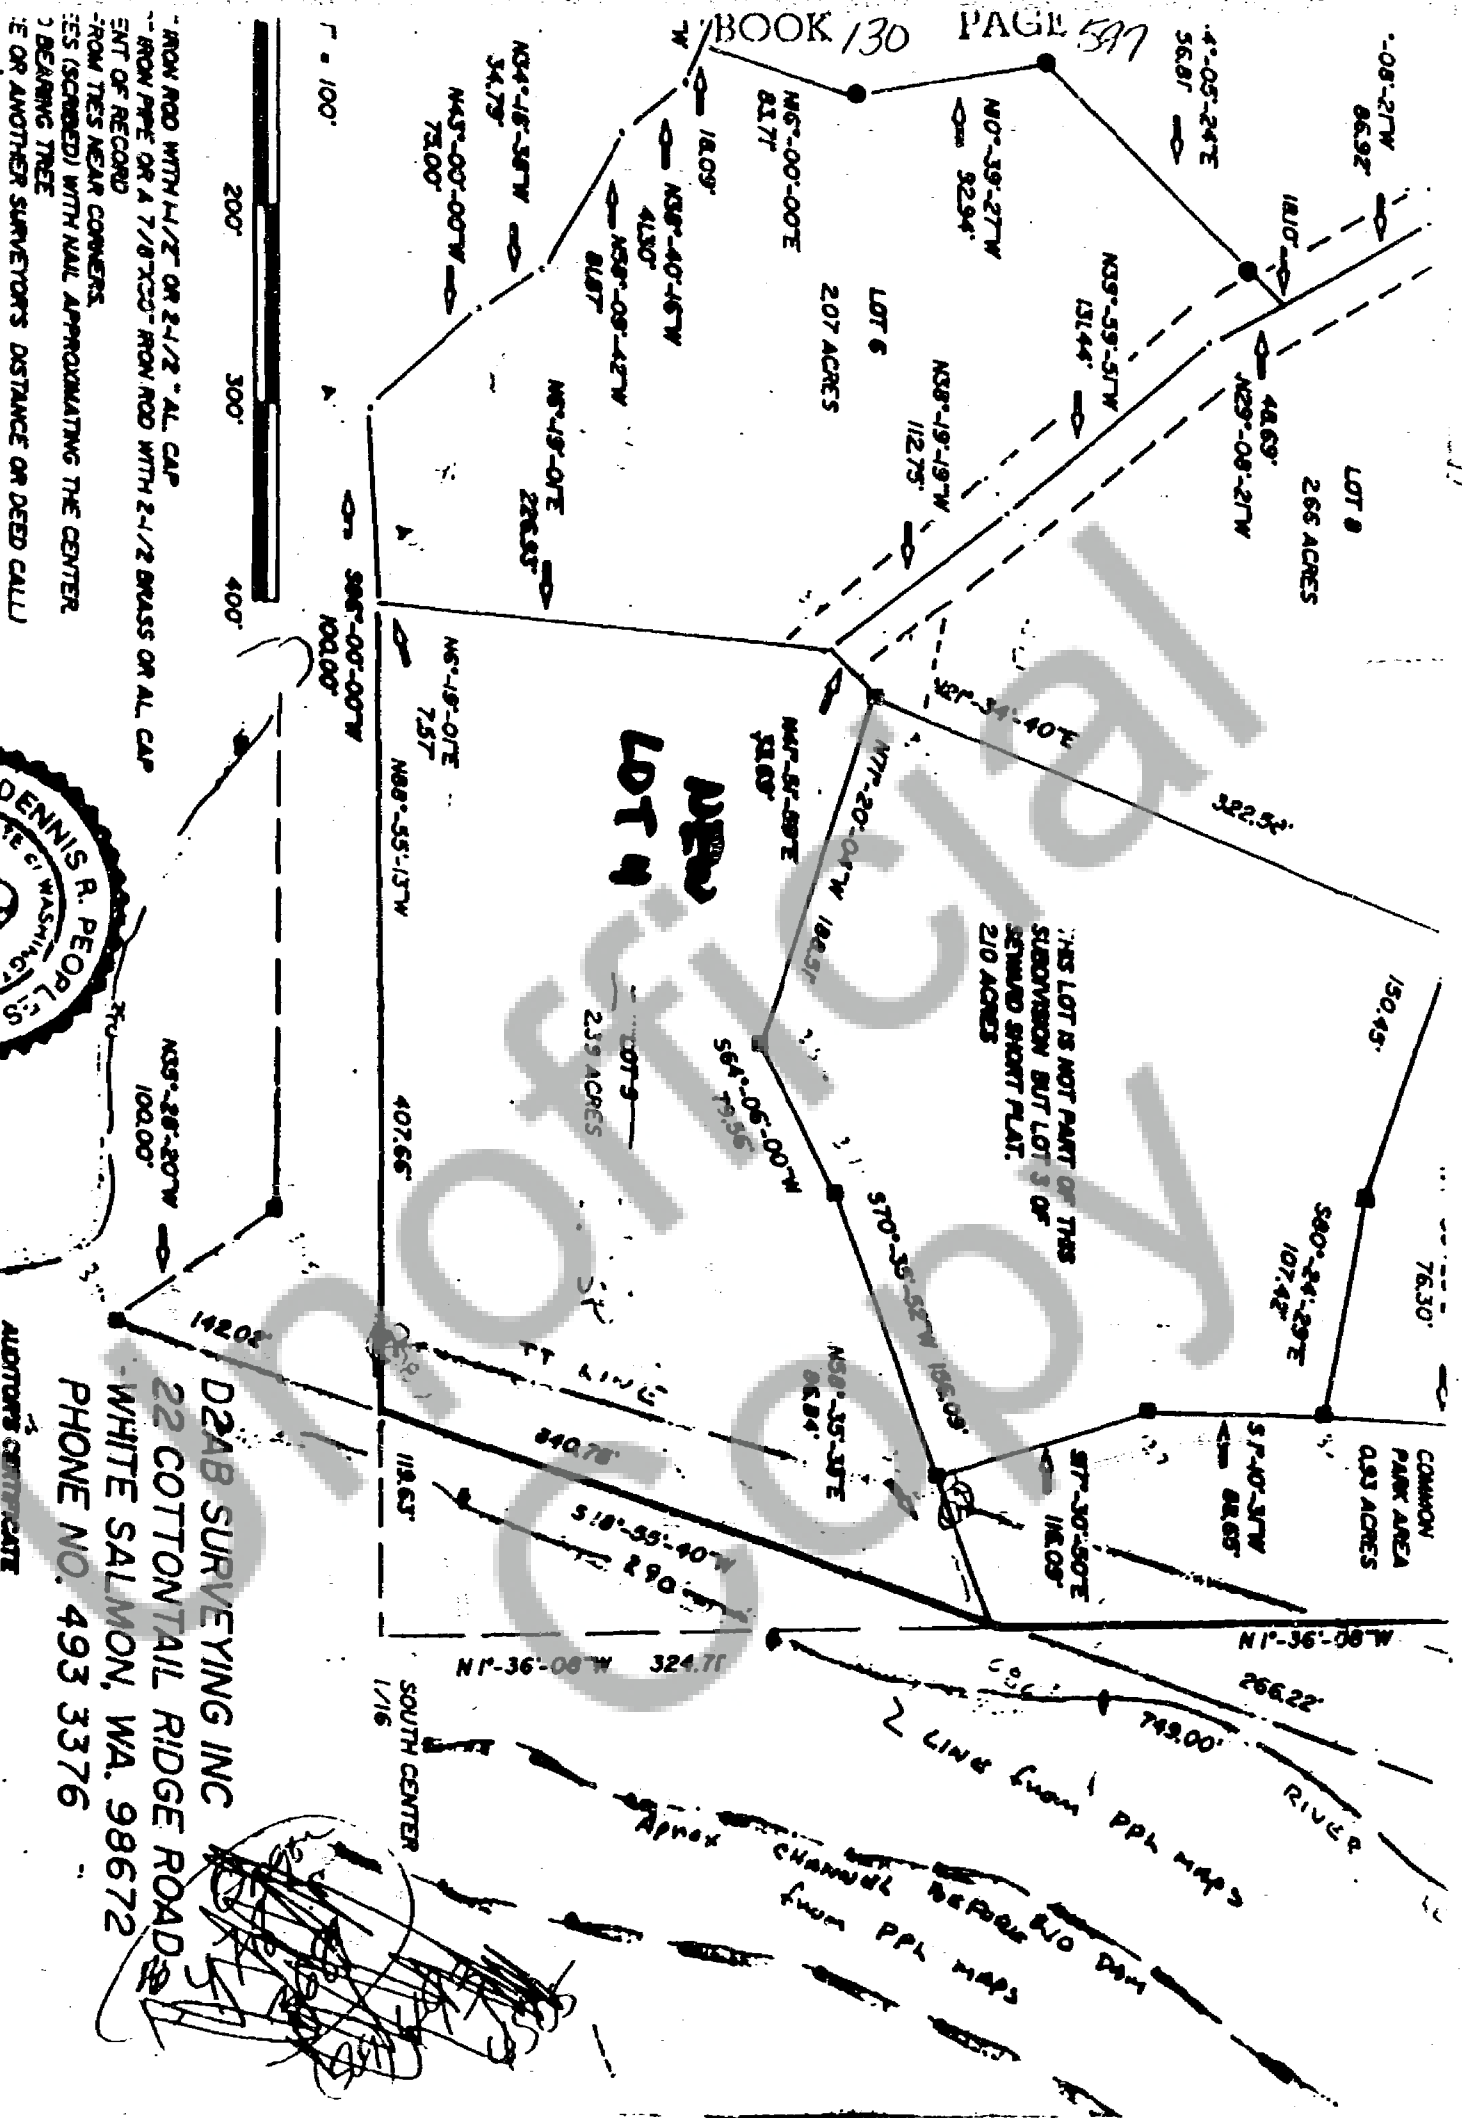

DATE
LY REPRESENTS A SURVEY MADE BY ME OR UNDER
INFORMANCE WITH THE REQUIREMENTS OF THE SURVEY
THE REQUEST OF DUST MOSS IN AUG 1991

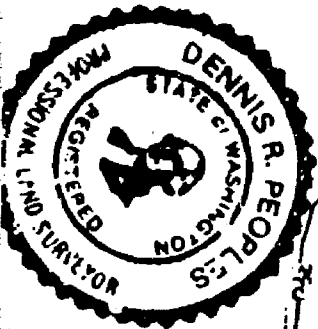

D2AB SURVEYING INC
22 COTTONTAIL RIDGE ROAD
WHITE SALMON, WA. 98672
PHONE NO. 493 3376

AUDITOR'S CERTIFICATE
FILED FOR RECORDING THIS _____ DAY OF _____, 1994.
AT _____ IN BOOK _____ OF PLATS _____ PAGE _____
AT THE REQUEST OF DEAN SURVEYING INC.

COUNTY AUDITOR