

EASEMENT AMENDMENT

This Easement and Amendment is made and entered into by and between the STATE OF WASHINGTON, acting by and through the Department of Natural Resources, herein called the "State," and LONGVIEW FIBRE COMPANY, a Delaware corporation, herein called "Longview Fibre," with reference to the following facts:

A. On October 5, 1977, Longview Fibre and the State entered into a certain Easement which was recorded in the records of Skamania County under Skamania County Auditor's File No. 85077 in Volume 71 of Deeds, Pages 635 - 639.

B. The State and Longview Fibre desire hereby to amend the Easement so as to delete a certain road therefrom.

NOW THEREFORE, the State and Longview Fibre mutually agree as follows:

1. There is hereby deleted from the Easement above described that certain road as shown in red on the attached Exhibit A, over and across portions of the NW $\frac{1}{4}$ of Section 3, Township 2 North, Range 7 East, W.M.

2. Except as herein expressly amended, the Original Easement is hereby confirmed and ratified and remains in full force and effect.

IN WITNESS WHEREOF, the parties hereto have executed this instrument, in duplicate as of this day and year first above written.

LONGVIEW FIBRE COMPANY

By W. Lee W. LEE
VICE PRESIDENT
Title

Attest: [Signature]
Title

Affix Seal of Corporation

STATE OF WASHINGTON
DEPARTMENT OF NATURAL RESOURCES

By Bert L. Cole
BERT L. COLE
Commissioner of Public Lands

Affix Seal of Commissioner
of Public Lands

Easement No. 1603

as



3001
TRANSACTION EXCISE TAX

JUN 23 1978
Amount Paid Excise Tax

Skamania County Treasurer
By [Signature]

STATE OF WASHINGTON)
) ss
 County of Cowlitz)

On this 30th day of May, 1978, before me personally appeared W. L. Robinson and G. E. Schwartz, to me known to be the Vice President-fiber and Secretary, respectively, of Longview Fibre Company, the corporation that executed the within and foregoing instrument, and acknowledged said instrument to be the free and voluntary act and deed of said corporation, for the uses and purposes therein mentioned, and on oath stated that they were authorized to execute said instrument and that the seal affixed is the corporate seal of said corporation.

IN WITNESS WHEREOF, I have hereunto set my hand and affixed my official seal the day and year first above written.

Notary Public in and for the State of
Washington, residing at Kelso

STATE OF WASHINGTON)
) ss
 COUNTY OF TIERSTON)

On this 1st day of June, 1978, before me personally appeared BERT L. COLE, to me known to be the Commissioner of Public Lands, and ex officio administrator of the Department of Natural Resources of the State of Washington, the Department that executed the within and foregoing instrument on behalf of the State of Washington, and acknowledged said instrument to be the free and voluntary act and deed of the State of Washington for the uses and purposes therein mentioned, and on oath stated that he was authorized to execute said instrument and that the seal affixed is the official seal of the Commissioner of Public Lands for the State of Washington.

IN WITNESS WHEREOF, I have hereunto set my hand and seal the day and year set forth above.

Notary Public in and for the State of
Washington, residing at Olympia

STATE OF WASHINGTON
DEPARTMENT OF NATURAL RESOURCES
REED L. COLL, Commissioner of Public Lands

BOOK 75 PAGE 77

Application No. _____

County. SKAMANIA

Name of Sale _____

District _____

TOWNSHIP 2 NORTH, RANGE 7 (E) W.M.

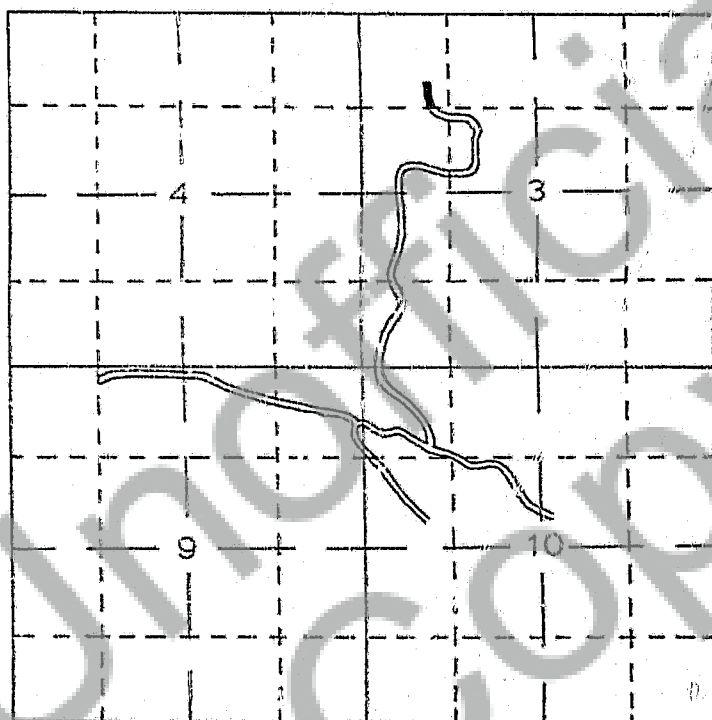


EXHIBIT 'A'

SCALE: 1" = 2000'

Drawn By: _____

Date: _____

LEGEND