


PAGE 273


SURVEYS

3

BOOK

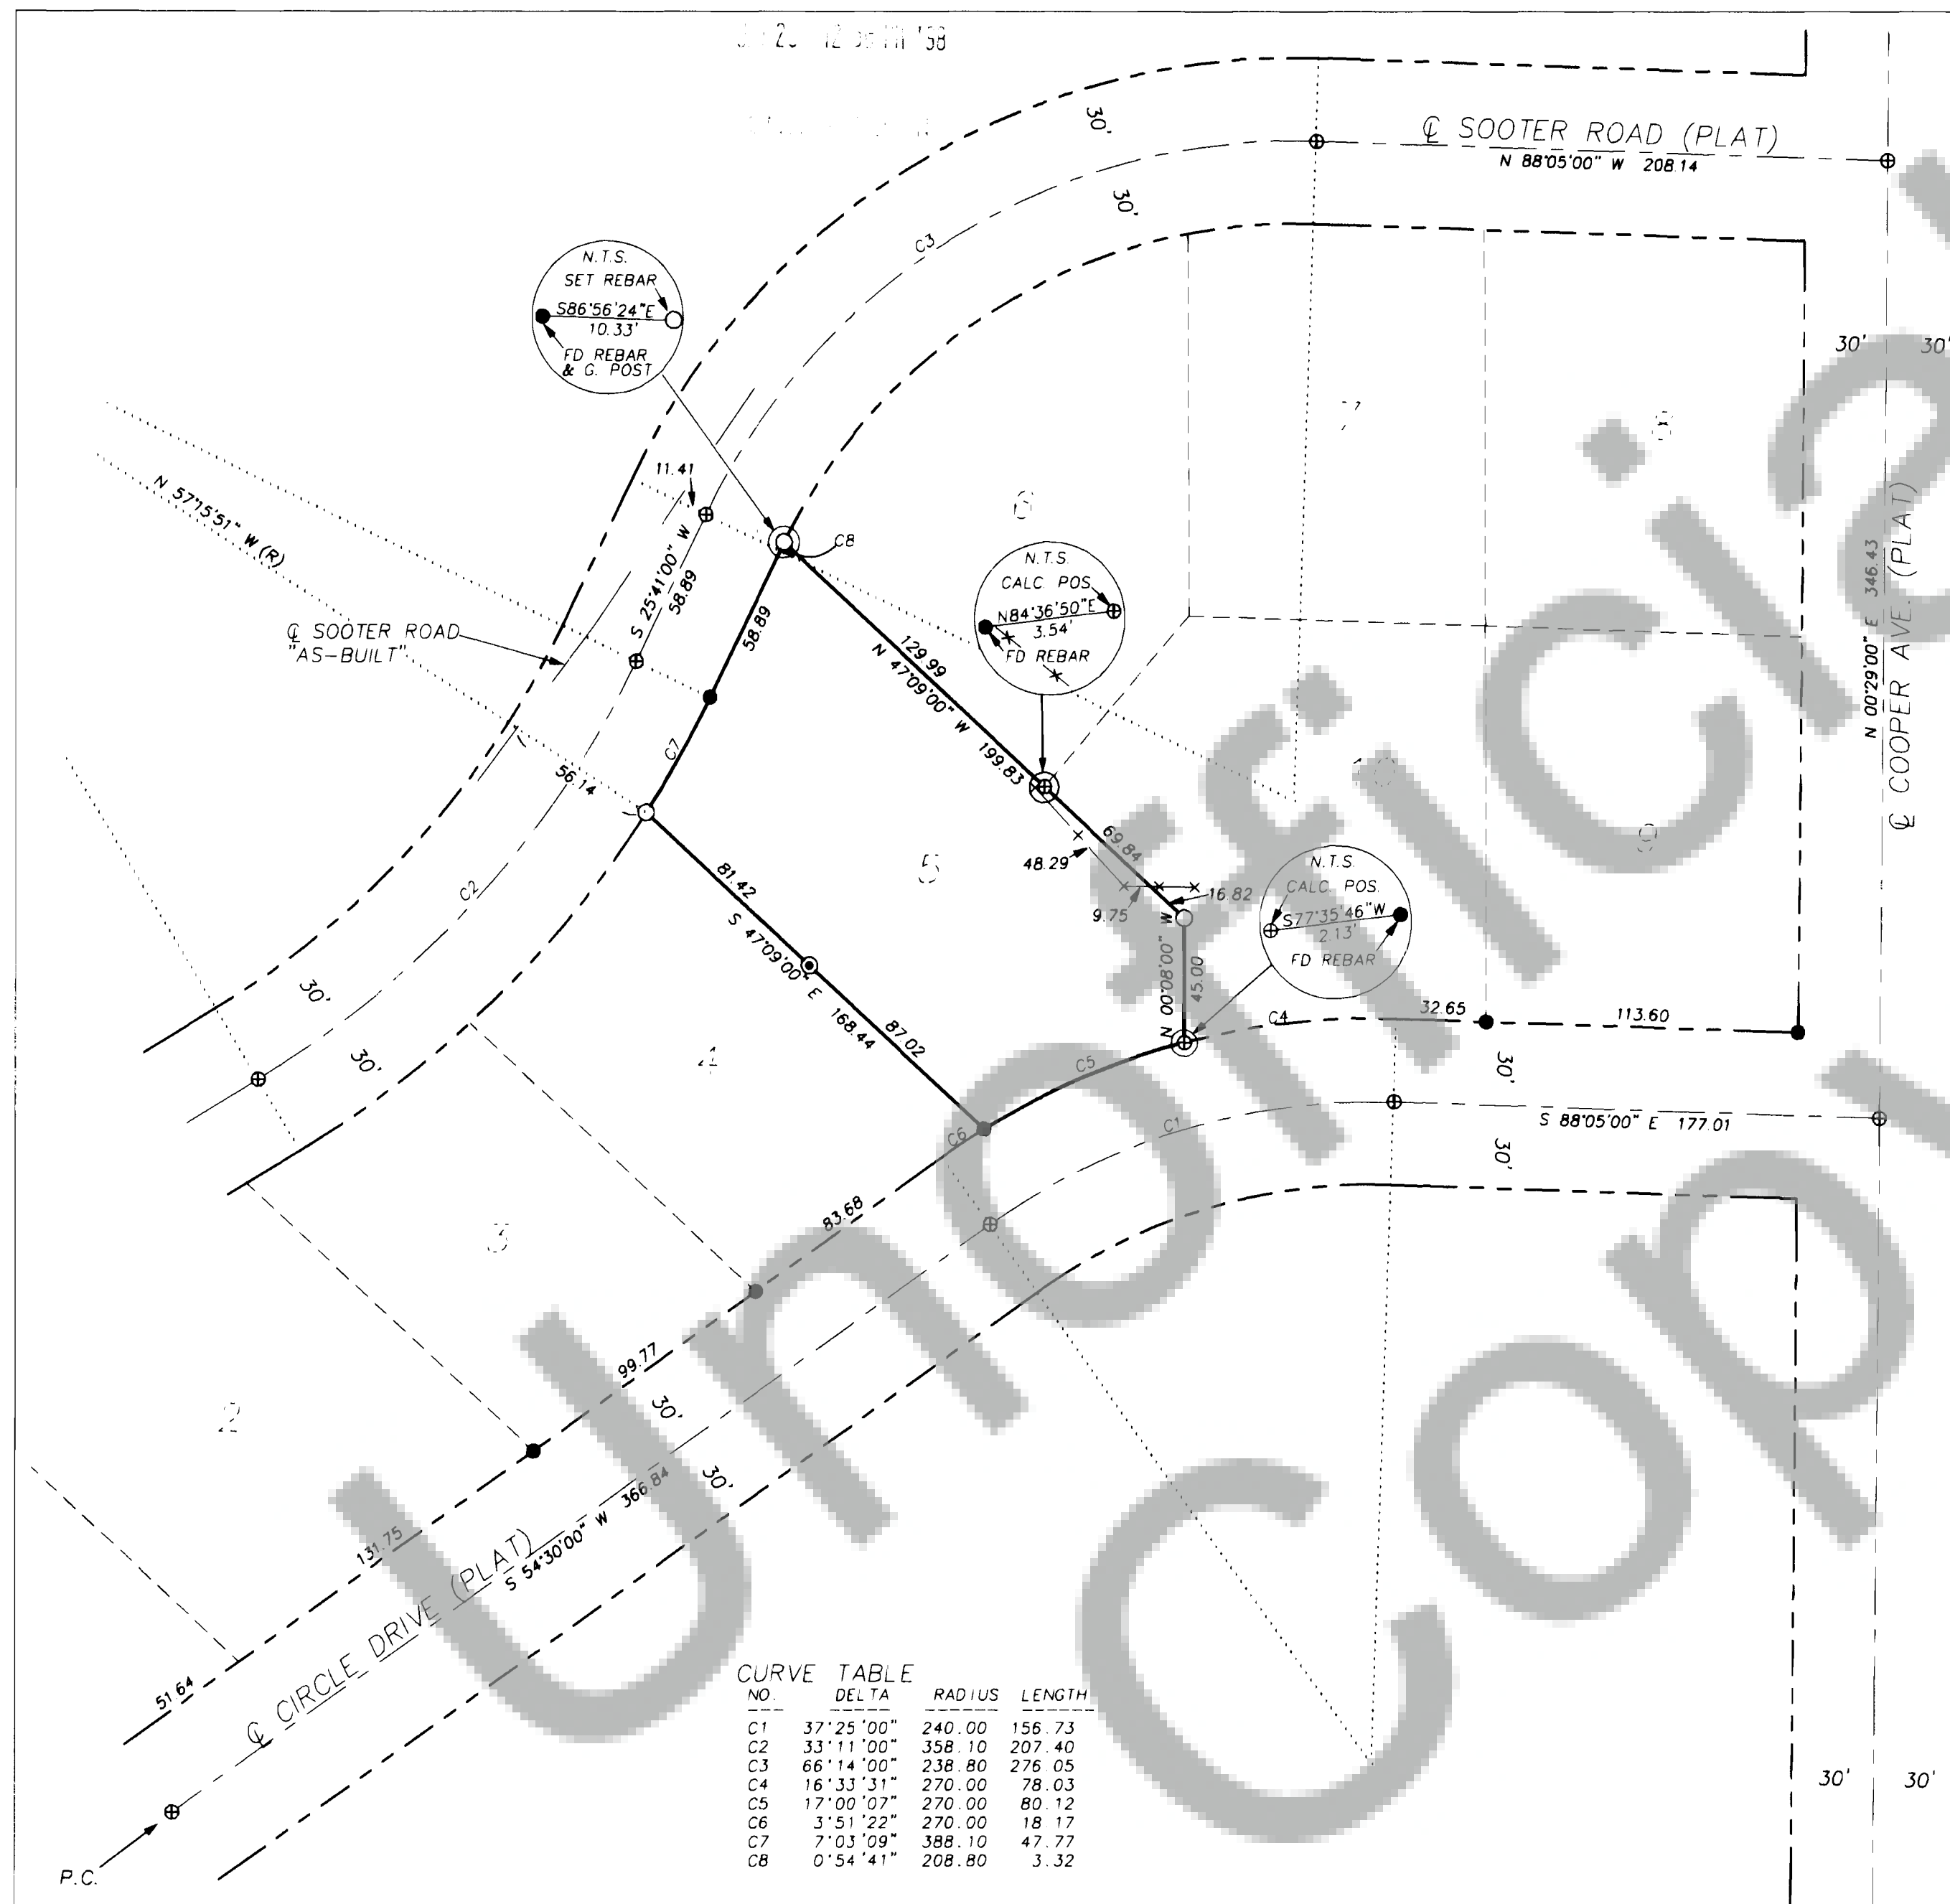

A PORTION OF THE
SE 1/4 OF THE NE 1/4
SECTION 22, T3N, R10E, W.M.

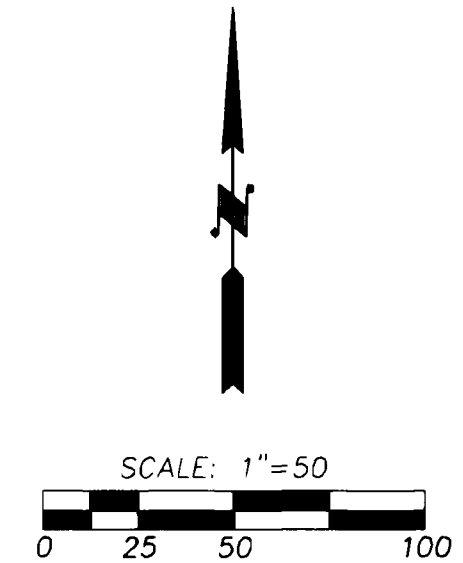

BASIS OF MERIDIAN: PLAT OF THE "SOOTER TRACTS" AS RECORDED IN VOLUME "A" OF PLATS AT PAGE 138, RECORDS OF SKAMANIA COUNTY, WASHINGTON.

LEGEND

- FOUND 5/8" REBAR W/O CAP
- SET 1/2" X 30" REBAR W/ CAP LS 18896
- ⊙ SET 1/2" X 30" REBAR W/ CAP LS 18896 "LINE ONLY"
- ⊕ CALCULATED POSITION
- ✕ FENCE LINE
- AS-BUILT ROAD CENTERLINE

METHOD OF SURVEY: CONVENTIONAL GROUND METHODS USING A SOKKIA DT6 (00'00'20") THEODOLITE AND LEITZ RED-2A E.D.M. THIS SURVEY MEETS OR EXCEEDS PRECISION REQUIREMENTS AS SET FORTH IN W.A.C. 332-130-070.

CERTIFICATE NO. _____

AUDITOR'S CERTIFICATE
FILED FOR RECORD THIS 28th DAY OF January, 1998
AT 12:35 P.M. IN BOOK 3 OF Surveys AT PAGE 273
AT THE REQUEST OF BUTLER & ZENKNER LAND SURVEYORS, INC.

Steve M. Olson by O. Lavery
COUNTY AUDITOR

SURVEYOR'S CERTIFICATE

THIS MAP CORRECTLY REPRESENTS A SURVEY MADE BY ME OR UNDER MY DIRECTION IN CONFORMANCE WITH THE REQUIREMENTS OF THE SURVEY RECORDING ACT AT THE REQUEST OF STEVE BERNTSEN IN DECEMBER OF 1997

Edward A. Butler
LICENSE NO. 18896

RECORD OF SURVEY DESCRIPTION

LOT 5 OF THE "SOOTER TRACTS" AS RECORDED IN VOLUME "A" OF PLATS AT PAGE 138, RECORDS OF SKAMANIA COUNTY WASHINGTON.

BUTLER & ZENKNER LANDSURVEYORS, INC.
475 NW CHEHALIS AVENUE
P.O. BOX 149, CHEHALIS, WA 98532
360/748-8803

DRN C. BUTLER / <i>CB</i>	DATE 1-14-98
CHK'D <i>EAB</i>	JOB NO. 97-299 IPC 97-299/ACAD 97-299A
SCALE 1"=50'	SHEET 1 OF 1

