


AMENDED RECORD OF SURVEY

IN A PORTION OF GOVERNMENT LOT 1 AND 2
LYING IN THE NW 1/4 OF SECTION 36
T3N, R7-1/2E, W4M
SKAMANIA COUNTY, WASHINGTON

300' B.P.A. RIGHT OF WAY AS DESCRIBED IN THE
DISTRICT COURT OF THE UNITED STATES FOR THE
WESTERN DISTRICT OF WASHINGTON SOUTHERN
DIVISION CASE NO. 34, DECLARATION OF TAKING,
RECORDED 02/03/39

CALCULATED POSITION OF U.S. ARMY BRASS
CAP AS SHOWN IN R.O.S. BK. 1, PG. 239 AND
ON THE BONNEVILLE POWER ADMINISTRATION
PLAN. (SEE NOTE BELOW)

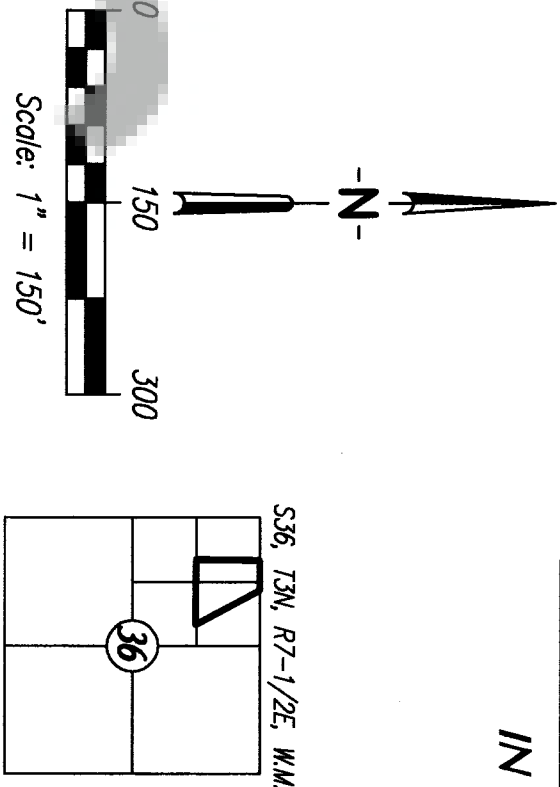

REASON FOR AMENDMENT
TO ADD A NOTE DOCUMENTING THE USE OF THE
NORTHWEST CORNER OF SECTION 36 AND ADD THE
LAND OWNER'S NAME TO THE SURVEYOR'S
CERTIFICATE TO THE RECORD OF SURVEY RECORDED
UNDER AUDITOR'S FILE NO. 2005158922

DEED REFERENCE

FOUND AND HELD 1-3/4"
WAGON AXLE, UP 1.9' AS SHOWN
IN R.O.S. BK. 1, PG. 239
BARGAIN AND SALE DEED
VIRGINIA GOOD
TO
VIRGINIA GOOD (TRUSTEE)
BK. 207, PG. 451-453
(RECORDED: 03/08/01)

LEGEND

- SET 5/8" x 24" IRON ROD WITH YELLOW PLASTIC CAP
STAMPED "PLS 32448" (6' GREEN STEEL "T" FENCE POST
SET NEXT TO IRON ROD AS WITNESS POST)
- SET 6' GREEN STEEL "T" FENCE POST ON DEED LINE
- MONUMENT AS NOTED (MONUMENTS NOTED
AS FOUND WERE TIED IN AUGUST, 2005)
- APPROXIMATE LOCATION OF PACIFIC NORTHWEST PIPELINE
CORPORATION GAS LINE
- () RECORD SURVEY DISTANCE
- { } RECORD DEED DISTANCE
- { } Y.P.C. YELLOW PLASTIC CAP
- R.O.S. RECORD OF SURVEY
- S.P. SHORT PLAT
- L.C.R. LAND CORNER RECORD

PROCEDURE


(SEE NARRATIVE)

* BASIS OF BEARINGS

R.O.S. BK. 1, PG. 239. (SEE NARRATIVE)

SURVEYOR'S CERTIFICATE

THIS MAP CORRECTLY REPRESENTS A SURVEY MADE BY ME
OR UNDER MY DIRECTION IN CONFORMANCE WITH THE
REQUIREMENTS OF THE SURVEY RECORING ACT AT THE
REQUEST OF DAN GREEN WITH WOODLAND MANAGEMENT
AGENT FOR THE OWNER, VIRGINIA GOOD IN OCTOBER, 2005.

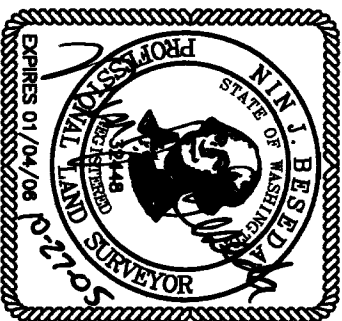

AUDITOR'S CERTIFICATE

FILED FOR RECORD THIS 1st DAY OF November, 2005,
AT 4:53 PM IN BOOK OF SURVEYS AT PAGE AT
THE REQUEST OF MACKAY & SPOSITO, INC. AT 2005154356

Deputy Surveyor
DEPUTY COUNTY AUDITOR

Mackay & Sposito, Inc.

ENGINEERS SURVEYORS PLANNERS

1326 SE TECH CENTER DRIVE, SUITE 140 VANCOUVER, WA 98683
(360) 695-3411 (509) 289-6726 PTLD FAX (360) 695-0833

CALC. BY: JMB DRAWN BY: JMB JOB NO.: 14224
CHECKED BY: NLB/DLS DWG. NAME: 14224RSJDWG SHEET 1 OF 1

NOTE

ANOTHER POSITION FOR THE NORTHWEST CORNER OF SECTION 36 WOULD BE WEST 18.25'
ACCORDING TO R.O.S. BK. 2, PG. 82 AND WEST 18.01' ACCORDING TO A 1967 SURVEY BY
BERT WASON, JR. ON FILE WITH THE SKAMANIA COUNTY ENGINEER'S OFFICE. THESE POSITIONS
WOULD PLACE THE CORNER ON THE SECOND GUIDE MERIDIAN (RANGE LINE). I CHOSE TO HOLD
THE MONUMENTED POSITION FOR THE "LOCAL" SECTION CORNER AS SHOWN IN R.O.S. BK. 1, PG.
239 WHICH WAS DONE FOR THE WESTERLY ADJOWER. THIS SURVEY HAS NOW BEEN RELED AND
IMPROVED UPON IN GOOD FAITH FOR THE PAST 25 YEARS. THE UNITED STATES DEPT. OF THE
INTERIOR'S (B.P.A.) PLAN FOR "BONNEVILLE - COULEE LINE 2" SHEET 7 OF 24 DATED
11-25-38 ALSO HELD THIS CORNER FOR THE PURPOSE OF THEIR SURVEY AND SUBSEQUENT
DECLARATION OF TAKING.

NOTE: MACKAY & SPOSITO INC. MAKES NO WARRANTIES AS
TO MATTERS OF UNWRITTEN TITLE SUCH AS ACQUISICENCE,
ESTOPPEL, ADVERSE POSSESSION, ETC.