

SURVEY in NE%NE% Sec.

Tax Parcel No. 02-06-34-1-0-1300-00

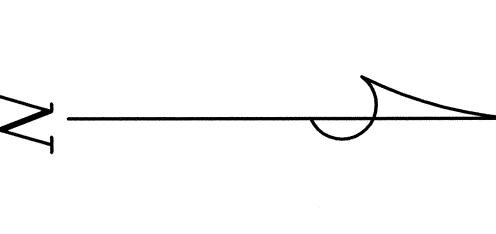

NARRATIVE: A closed loop with radial ties to monuments of record was traversed about the entire parcel. The purpose of this survey was to monument the four corners of the parcel.

TRAVERSE STATEMENT: Fieldwork was conducted during the period March 3 — May 19, 2008. Equipment used: Topcon GPT—3003LW total station last inspected in January of 2008 by PPI, Portland, OR.

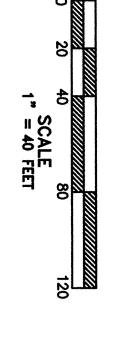

LEGEND

#10670

1.25

N88*48/04*W

208,71

Set 5/8"X30" iron rod w/1" red plastic cap


LS12412 IR/PC 0 Surveyor's License# on ca Iron rod w/plastic cap Monument of record

Fenceline

• EM Electric meter

OUP

Utility pole Electric line

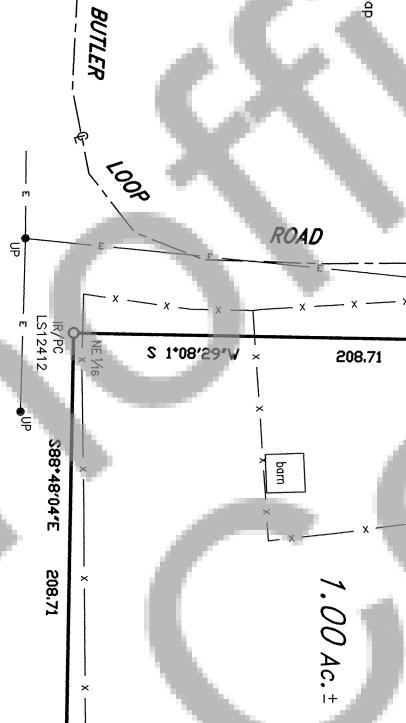

N 1*08'29'E

208.71

REFERENCES: 1. B.3, P.28 of Surveys, AF#108798 Basis of bearings is the South line of the NE¼NE¼ from Reference 1.

Trantow Surveying makes no warranty as to matters of unwritten title; environmental concerns; the accuracy or position of features shown without dimension.

TRANTOW SURVEYING, INC.
412 W. Jefferson-POB 287
Bingen, WA 98605-0287
Ph 509/493-3111 Fx 509/493-4309
Member of Land Surveyor's Assoc. of Washington

SURVEY FOR

B LINDA

SKAMANIA CO., WASHINGTON

#2618 Copyright 2008

80-82-8

SURVEYOR'S CERTIFICATE

This map correctly represents a survey made by me or under my direction in conformance with the requirements of the Survey Recording Act at the request of James Croy in February, 2008.

Terry N. Troptow, PLS 15673 28/08 Date

> AUDITOR'S CERTIFICATE

Filed for record this 9 day of Suppose, 2008 at 1:48PM recorded by AF# 2008170953 in Surveys at the

request of Trantow Surveying