

RECORD OF SURVEY

A PORTION OF SECTIONS 24, 25, 26 AND 35, TOWNSHIP 10N, RANGE 4E, W.M.,
 COMITZ COUNTY, WASHINGTON AND A PORTION OF SECTIONS 19 AND 30, TOWNSHIP 10N, RANGE 5E, W.M., SKAMANIA COUNTY, WASHINGTON

NOTE:

COUNTY LINE NORTH OF THE SOUTHEAST CORNER OF SECTION 24 IS FOR GRAPHIC REPRESENTATION ONLY (NOT ESTABLISHED BY THIS SURVEY).



AUDITOR'S CERTIFICATE

FILED FOR RECORD THIS 21 DAY OF April, 2010,
AT 29 MINUTES PAST 11 A.M.
RECORDS OF THE SKAMANIA COUNTY AUDITOR, STEVENSON, WASHINGTON
RECORDING NUMBER 2010175315. FEE \$148.00

Timothy O. Todd
SKAMANIA COUNTY AUDITOR


Multi-Track

SURVEYOR'S CERTIFICATE

THIS MAP CORRECTLY REPRESENTS A SURVEY MADE BY ME OR UNDER MY DIRECTION IN CONFORMANCE WITH THE REQUIREMENTS OF THE SURVEY RECORDING ACT AT THE REQUEST OF ST. HELEN'S L.L.C., IN SEPTEMBER, 2008.

4/16/10
DATE

DATE 4/16/10

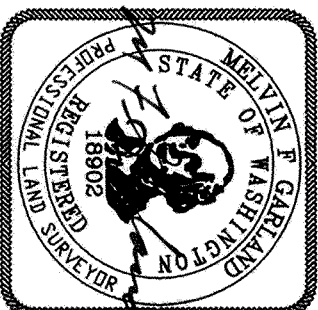

RECORD OF SURVEY

FOR
HIGH LAKES ROAD
SYSTEM AS-BUILT

DWG. NO: 30887ROS.dwg

DATE: 11/20/2008

DRAWN BY: SLS

AUDITOR'S INDEXING DATA

SURVEY IN:

SEC. 24. SE 1/4 OF NW 1/4, E
1/2 OF SW 1/4, W 1/2 OF
SE 1/4

SEC. 25. NE 1/4, NW 1/4, SW
1/4, W 1/2 OF SE 1/4

SEC. 26. E 1/2 OF SE 1/4, SW
1/4 OF SE 1/4, SE 1/4 OF
SW 1/4

SEC. 35. NE 1/4, E 1/2 OF NW
1/4, NE 1/4 OF SW 1/4,
NW 1/4 OF SE 1/4

SEC. 39. NE 1/4, NW 1/4, SE 1/4
SW 1/4

SEC. 30. N 1/2

STATE PLANE CO-ORDINATE LIST

DESCRIPTION	NORTHING	EASTING
S.W. CORNER SECTION 25	362190.3607	1195280.1662
S. QTR. CORNER SECTION 25	362134.6837	11917906.0554
CTR. SECTION 25	364754.1444	1197976.8165
E. QTR. CORNER SECTION 25	3646690.1802	1200682.2012
N.E. CORNER SECTION 25	367337.5674	1200682.3455
N.W. CORNER SECTION 30	367168.5143	1200676.8866

NOTES:

1) THIS SURVEY DOES NOT PURPORT TO SHOW ANY OR ALL EASEMENTS ENCUMBERING THIS SITE. YOUR TITLE INSURANCE POLICY IS A RESOURCE TO CONSULT FOR INFORMATION REGARDING EASEMENTS WHICH MAY AFFECT YOUR PROPERTY.

2) THIS SURVEY WAS PREPARED FOR THE EXCLUSIVE USE OF ST. HELEN'S L.L.C. AND DOES NOT EXTEND TO ANY UNNAMED PERSON OR PERSONS WITHOUT EXPRESS CERTIFICATION BY SURVEYOR NAMING SAID PARTY.

SHEET INDEX

SHEET 1 -- SURVEY BASE MAP
SHEET 2 THROUGH 4 -- ROAD/EASEMENT DETAIL MAPS
SHEET 5 -- LINE AND CURVE TABLES

REFERENCE

1. RECORD OF SURVEY, AFN 850321009, RECORDED MARCH 21, 1985, ARCHIE B. CARPENTER, LS 16196

BASIS OF BEARINGS

ALL BEARINGS NOTED ARE ON WASHINGTON STATE PLANE COORDINATE SYSTEM SOUTH ZONE, NAD 83/91. DISTANCES NOTED ARE GRID, TO CONVERT TO GROUND DISTANCES DIVIDE BY THE SCALE FACTOR OF 0.999982533.

METHODS AND EQUIPMENT

SURVEY PERFORMED WITH A 1" TOTAL STATION, USING TRAVERSE AND RADIAL SURVEY METHODS. SURVEY MEETS OR EXCEEDS ACCURACY REQUIREMENTS CONTAINED IN WAC 332.150.090.

LEGEND

CENTER SECTION

25

(M) MEASURED DISTANCE

SHEET 1 OF 5

JOB NO. 30887



2601 South 35th, Suite 200
Tacoma, Washington 98409-7479
473-4494 FAX: (253) 473-0599

RECORD OF SURVEY

A PORTION OF SECTIONS 24, 25, 26 AND 35 TOWNSHIP 10N, RANGE 4E, W.M.,
COWLITZ COUNTY, WASHINGTON AND A PORTION OF SECTIONS 19 AND 30, TOWNSHIP 10N, RANGE 5E, W.M.,
SKAMANIA COUNTY, WASHINGTON



SEE SHEET 3 OF 5
FOR CONTINUATION

SEE SHEET 3 OF 5 FOR CONTINUATION

MARK E. GARLAND
STATE OF WASHINGTON
REGISTERED PROFESSIONAL ENGINEER
LICENSE NO. 188902
4/16/10

RECORD OF SURVEY
FOR
HIGH LAKES ROAD
SYSTEM AS-BUILT

DWG. NO.: 30887R05.dwg
DATE: 11/20/2008
DRAWN BY: SIS

SCALE: 1" = 1000'
CHECKED BY: MFG




Apex
Engineering

2601 South 35th, Suite 200
Tacoma, Washington 98409-7479
(253) 473-4494 FAX: (253) 473-0589


SHEET 2 OF 5
JOB NO. 30887

RECORD OF SURVEY


A PORTION OF SECTIONS 24, 25, 26 AND 35, TOWNSHIP 10N, RANGE 4E, W.M.,
COWLITZ COUNTY, WASHINGTON AND A PORTION OF SECTIONS 19 AND 30, TOWNSHIP 10N, RANGE 5E, W.M.,
SKAMANIA COUNTY, WASHINGTON

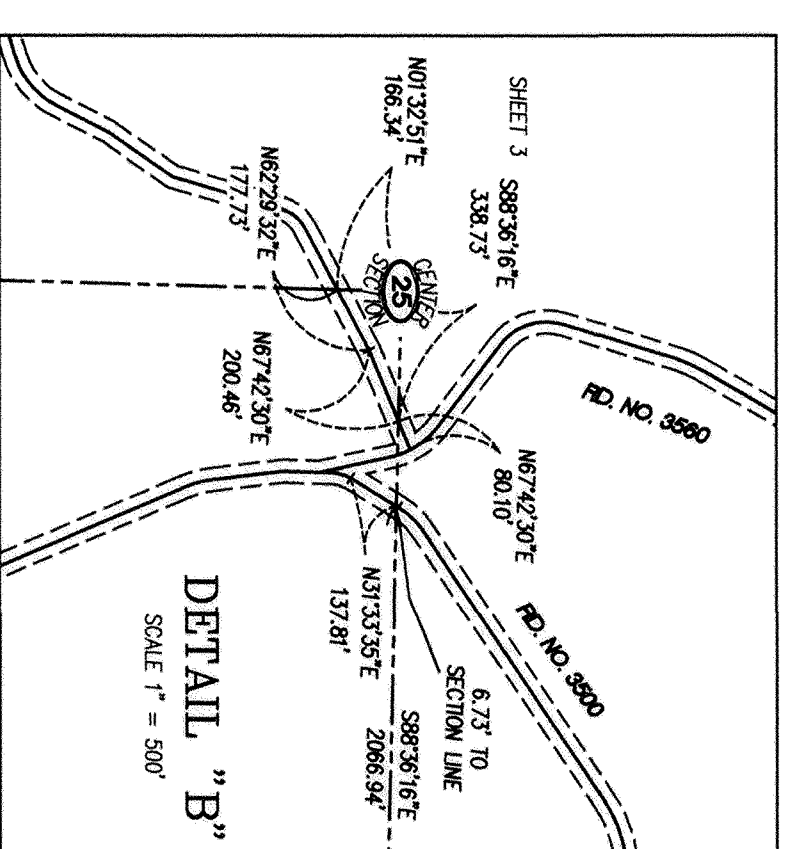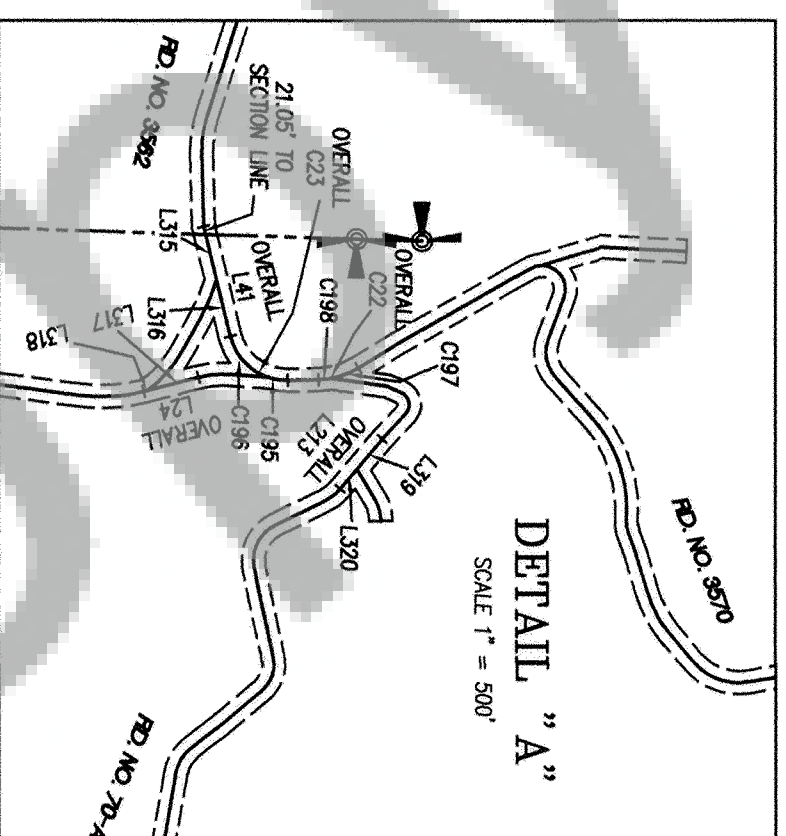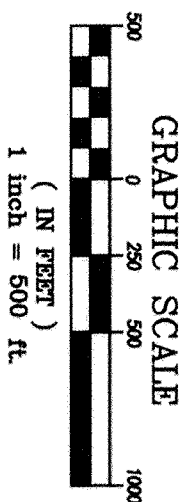

SEE SHEET 2 OF 5 FOR CONTINUATION

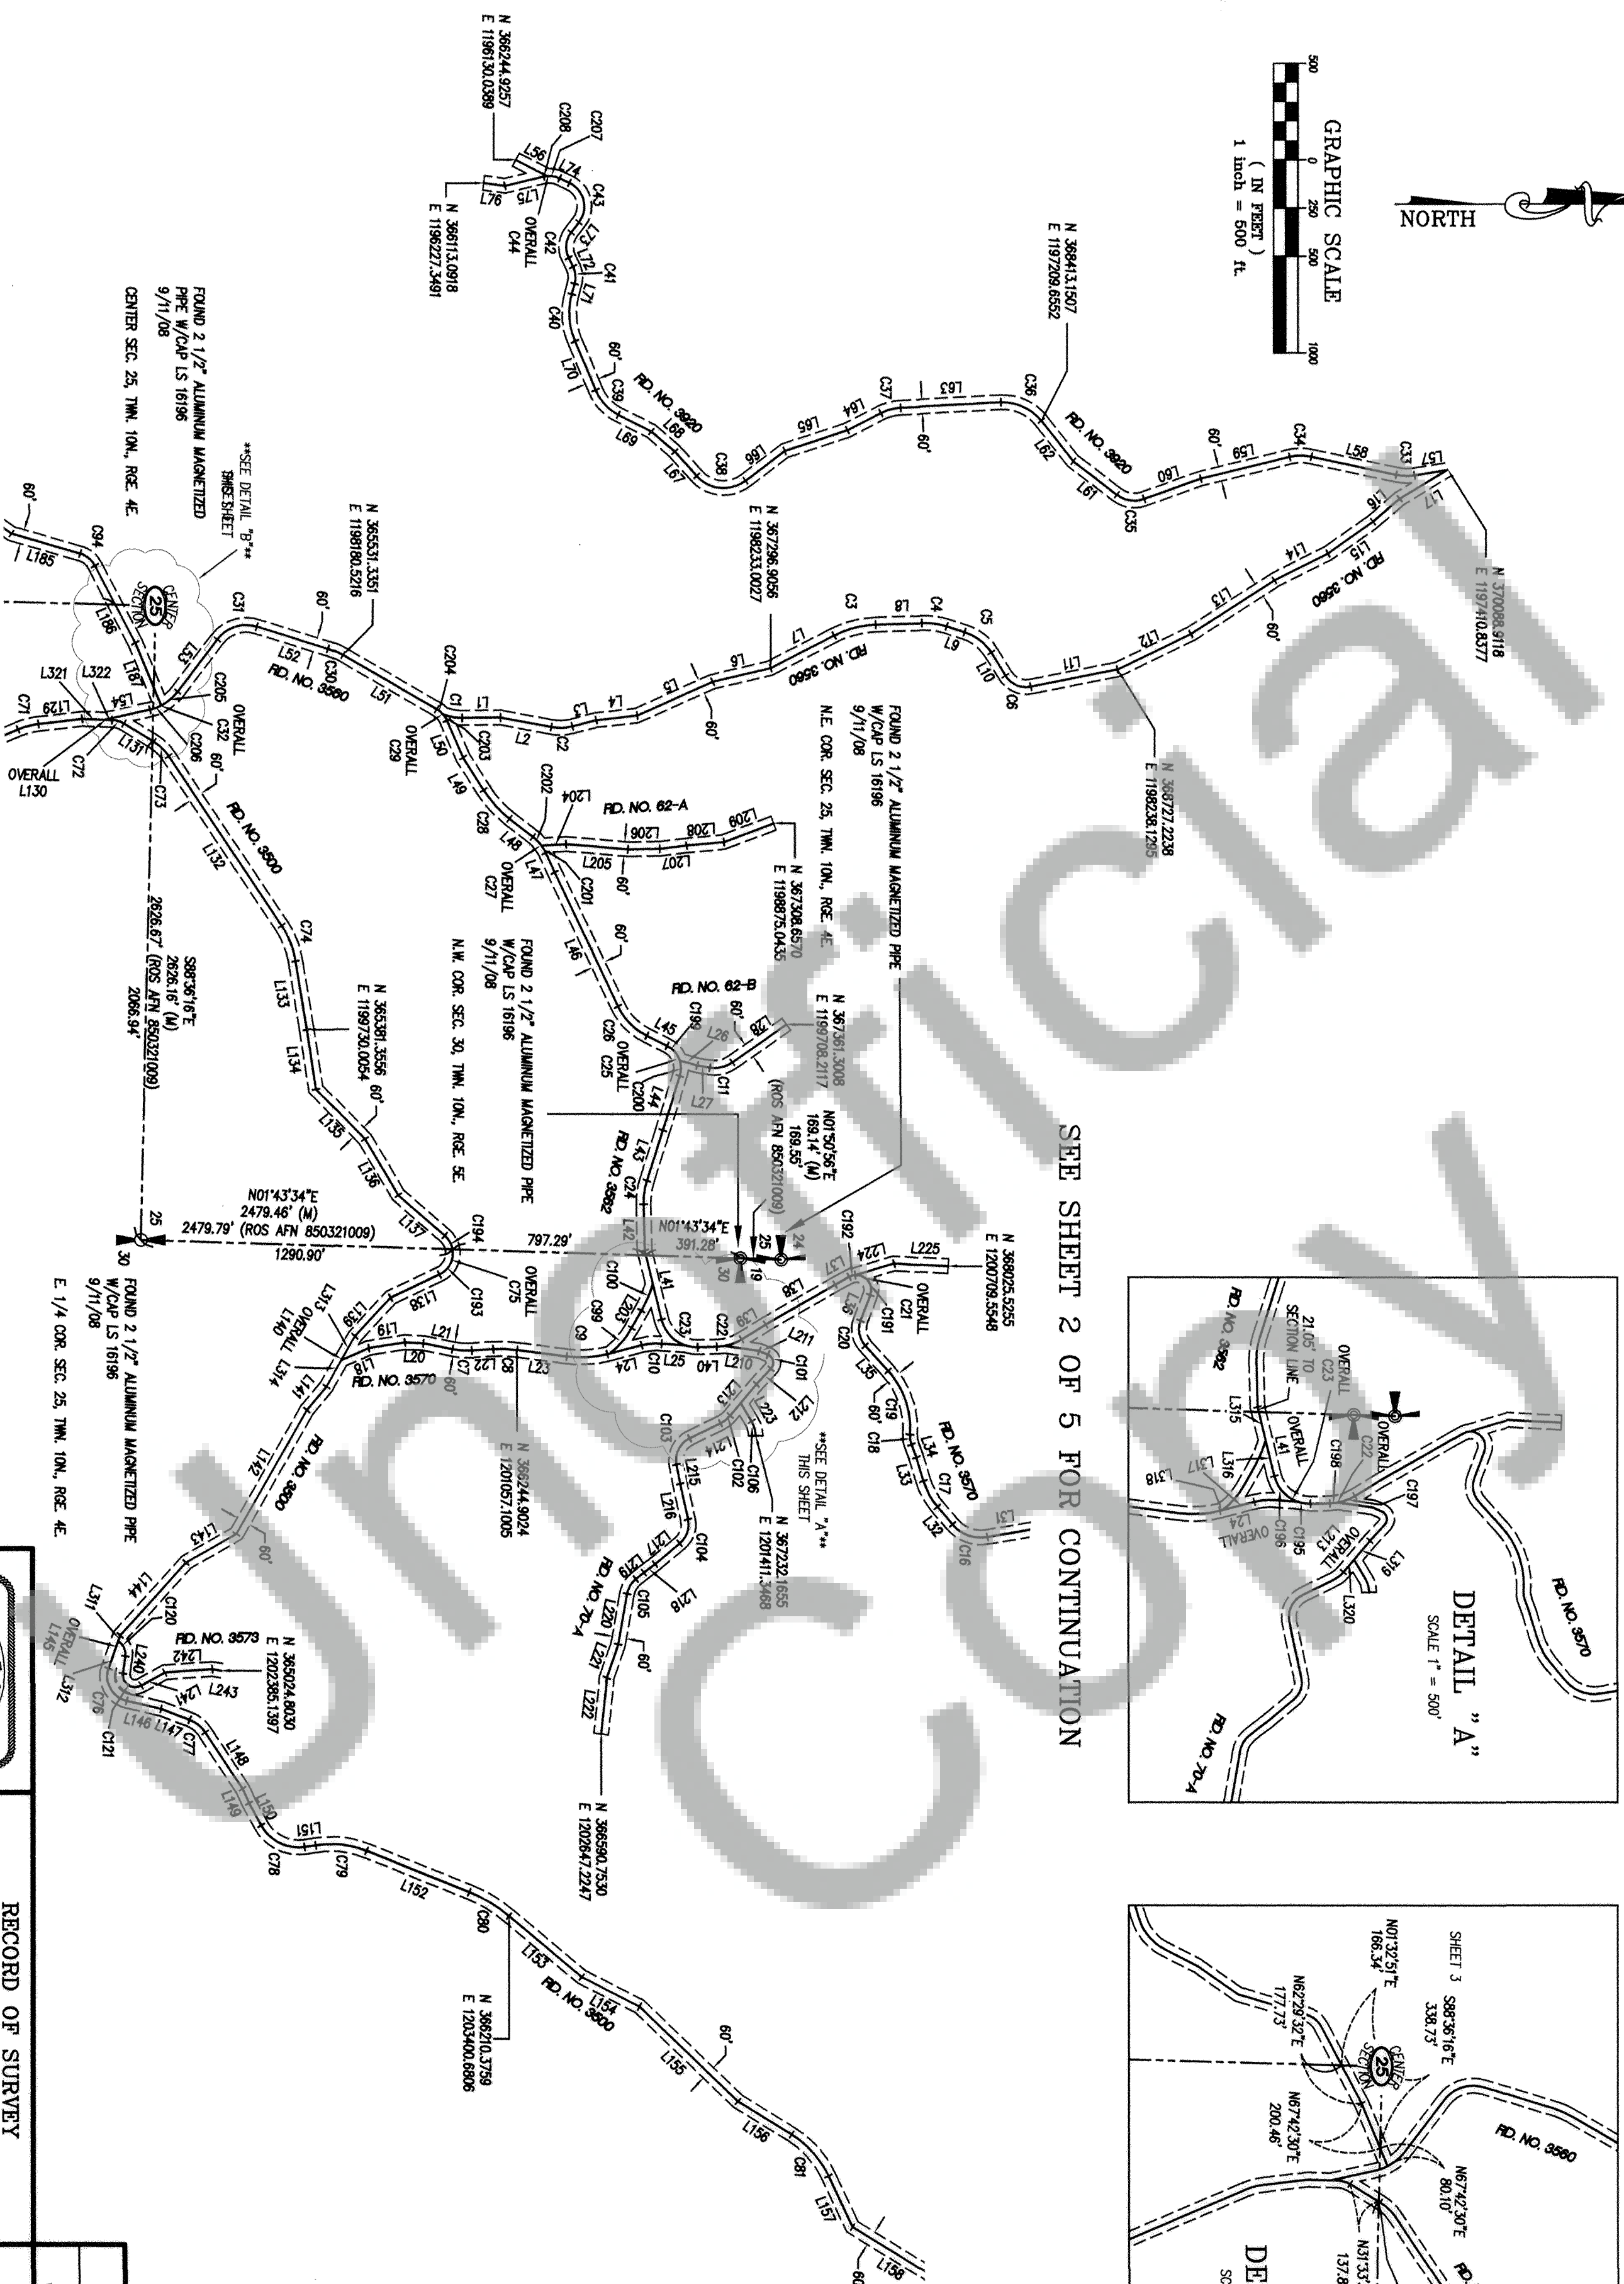

SEE SHEET 4 OF 5 FOR CONTINUATION

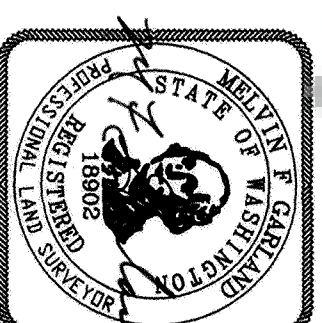

RECORD OF SURVEY FOR HIGH LAKES ROAD SYSTEM AS-BUILT

DWG. NO: 30887ROS.dwg

SCALE: 1" = 1000'

DRAWN BY: SIS

CHECKED BY: MFG

SHEET 3 OF 5
JOB NO. 30887



SHEET 3 OF 5

Apex
Engineering

2601 South 35th, Suite 2000
Tacoma, Washington 98409-7479
Tel: (253) 473-4494 FAX: (253) 473-0599

A PORTION OF SECTIONS 24, 25, 26 AND 35, TOWNSHIP 10N, RANGE 4E, W.M.,
COWLITZ COUNTY, WASHINGTON AND A PORTION OF SECTIONS 19 AND 30, TOWNSHIP 10N, RANGE 5E, W.M.,
SKAMANIA COUNTY, WASHINGTON

NORTH

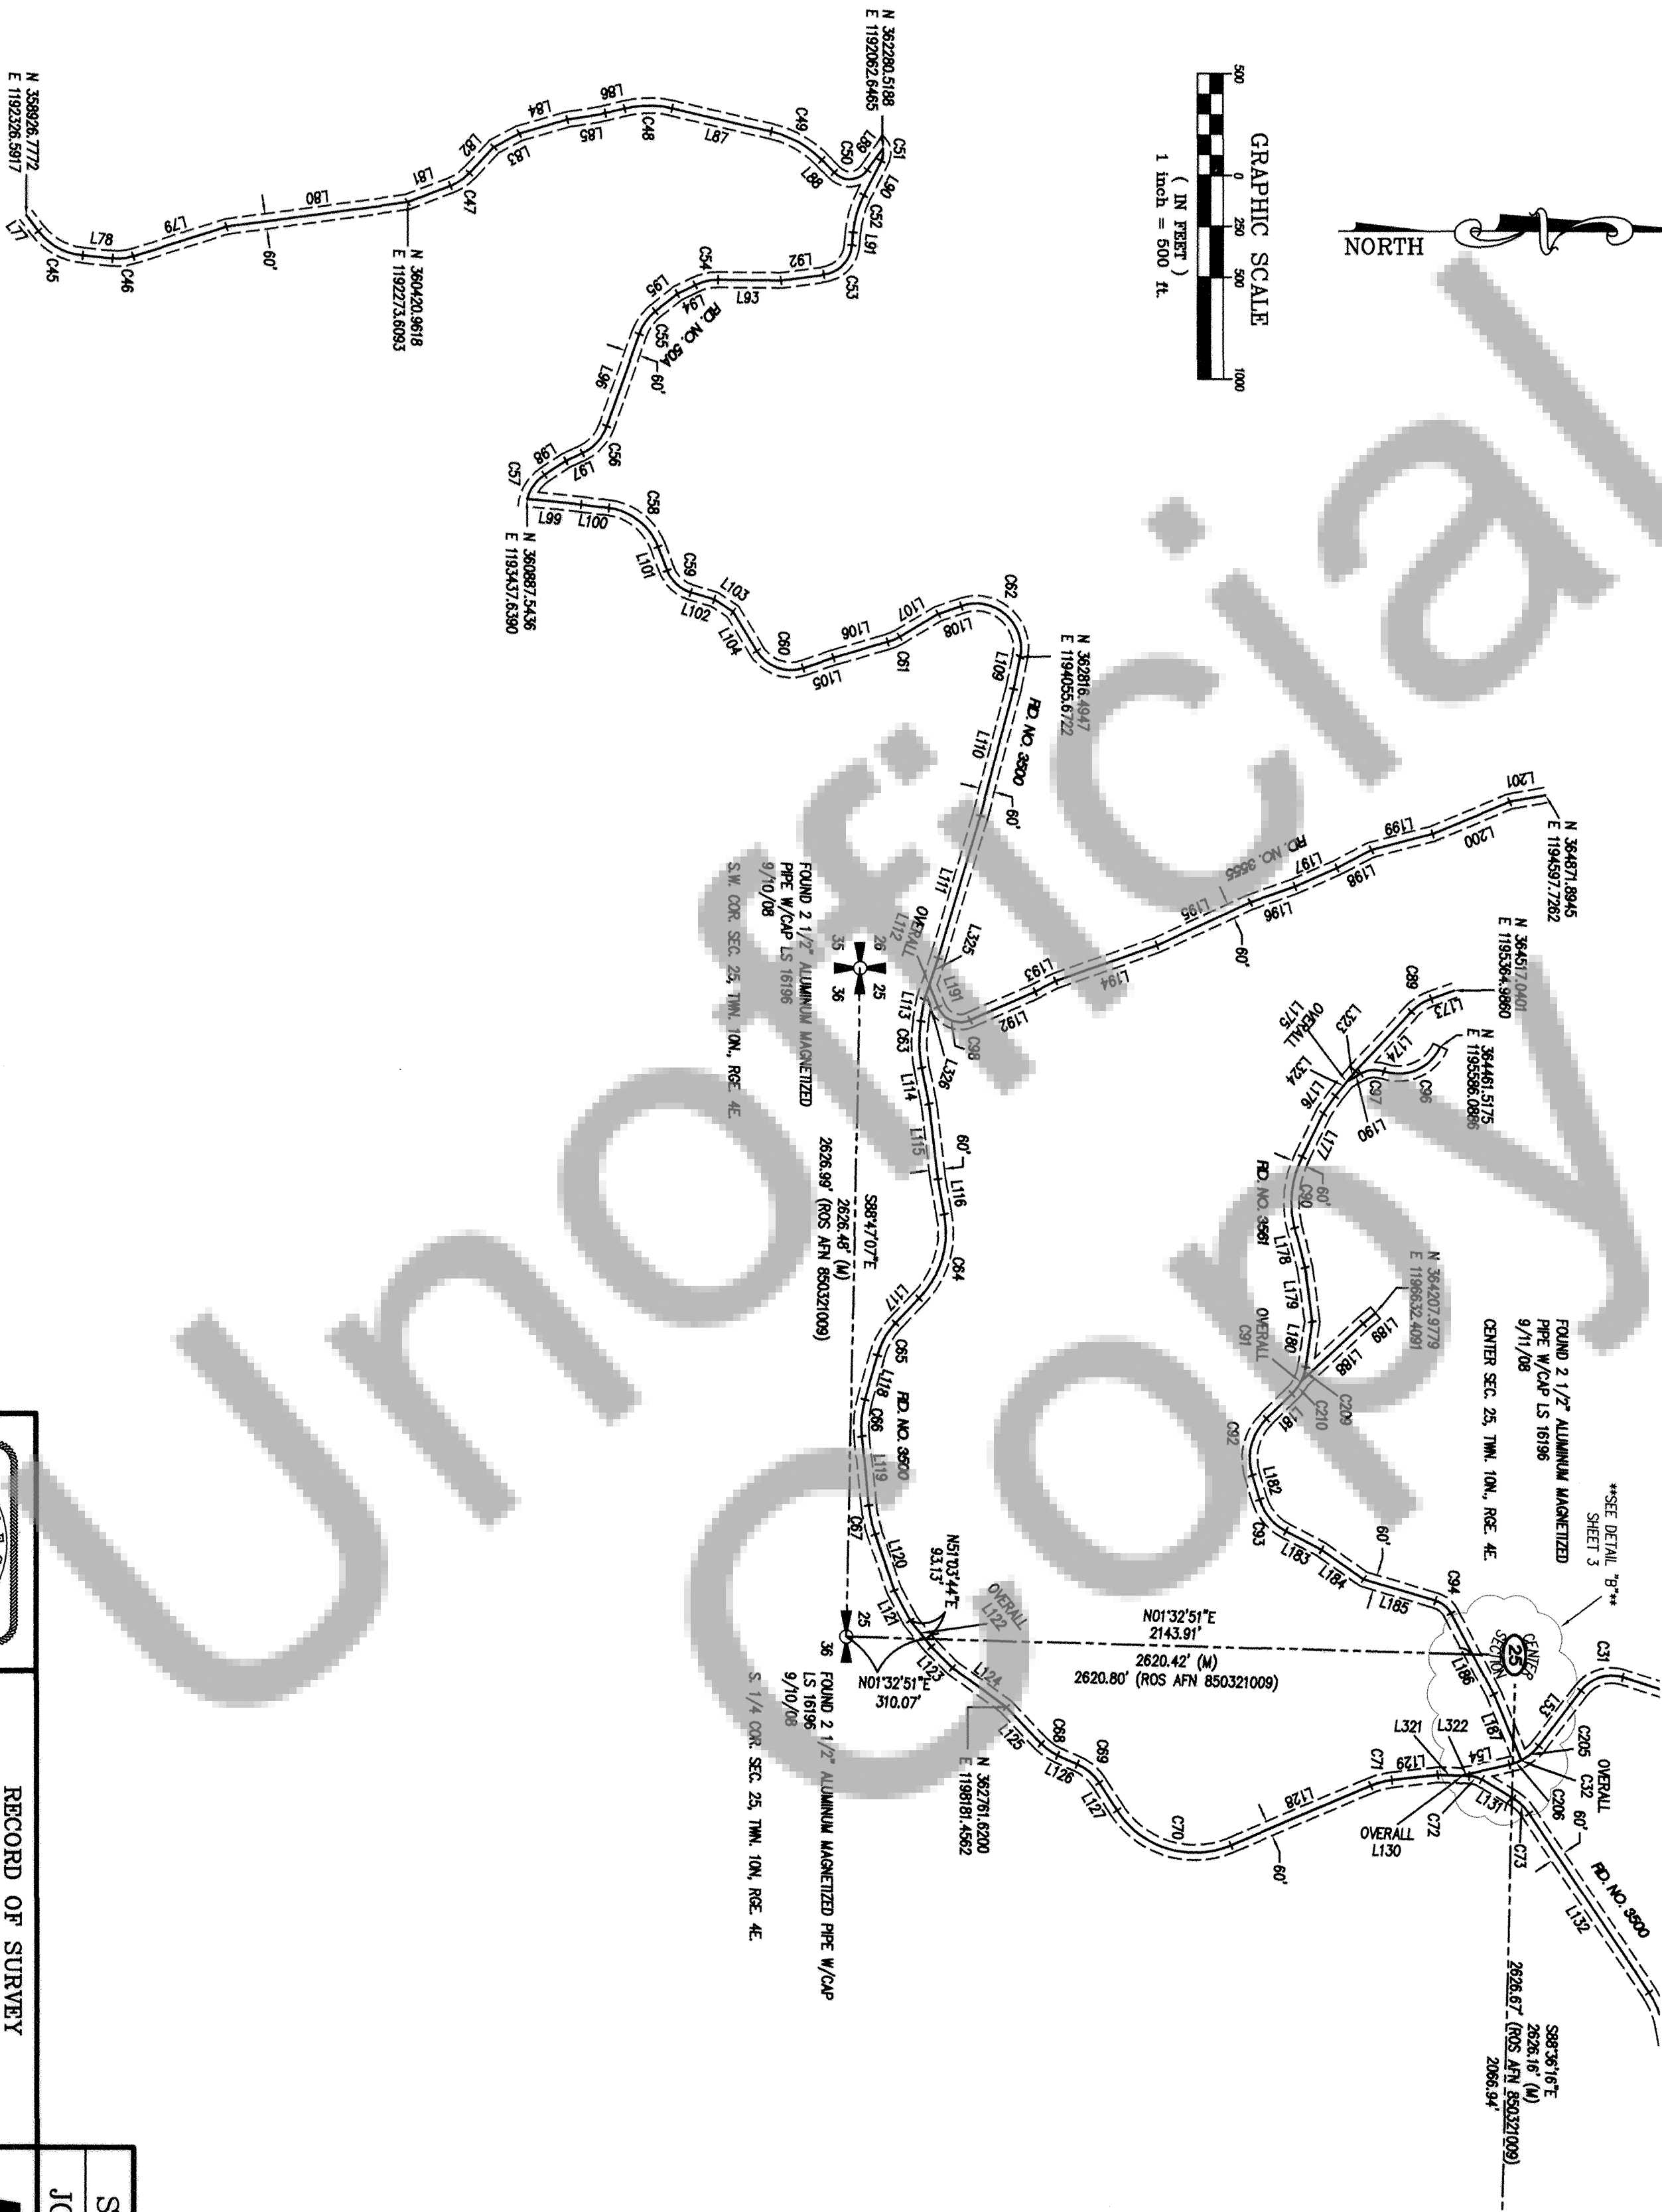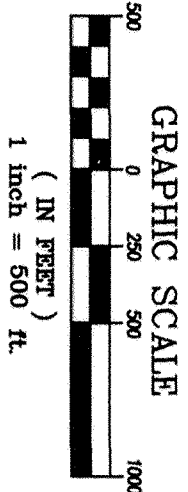

RECORD OF SURVEY FOR HIGH LAKES ROAD SYSTEM AS-BUILT

DWG. NO: 30887ROS.dwg

DATE: 11/20/2008

SCALE: 1" = 1000'

DRAWN BY: SLS

CHECKED BY: MFG

SHEET 4 OF 5

JOB NO. 30887



Apex
Engineering

2601 South 35th, Suite 200
Tacoma, Washington 98409-7477
473-4494 FAX: (253) 473-0594
(253)

A PORTION OF SECTIONS 24, 25, 26 AND 35, TOWNSHIP 10N, RANGE 4E, W.M.,
COWLITZ COUNTY, WASHINGTON AND A PORTION OF SECTIONS 19 AND 30, TOWNSHIP 10N, RANGE 5E, W.M.,
SKAMANIA COUNTY, WASHINGTON

RECORD OF SURVEY

LINE TABLES

LINE TABLE		
LINE	LENGTH	BEARING
L1	157.36	N00°34'07"W
L2	217.71	N03°08'07"E
L3	101.72	N14°37'51"W
L4	1171.77	N06°31'44"W
L5	342.34	N24°11'30"W
L6	246.86	N13°10'56"W
L7	296.64	N27°19'56"W
L8	190.11	N01°31'22"W
L9	76.95	N17°32'44"E
L10	112.02	N58°08'47"E
L11	366.93	N11°15'47"W
L12	337.73	N25°44'48"W
L13	411.27	N32°47'15"W
L14	247.36	N26°51'55"W
L15	226.57	N35°24'23"W
L16	146.20	N40°31'34"W
L17	228.09	N31°32'01"W
L18	124.19	N23°46'54"W
L19	151.28	N09°04'45"W
L20	76.39	N02°31'03"E
L21	121.84	N11°38'24"E
L22	87.32	N03°42'31"W
L23	206.61	N07°29'37"E
L24	146.64	N14°32'54"W
L25	98.76	N04°22'28"E
L26	74.94	N15°32'28"E
L27	53.07	N08°47'26"E
L28	272.78	N34°58'55"W
L29	448.41	S01°02'17"E
L30	191.20	S00°26'30"E
L31	247.33	S09°57'43"E
L32	95.41	S49°57'19"W
L33	102.77	S73°22'16"W
L34	57.40	S89°46'59"W
L35	141.57	S48°11'51"W
L36	114.13	N68°21'00"E
L37	65.68	S29°09'39"E
L38	332.45	S29°56'09"E
L39	116.80	S19°46'47"E
L40	79.25	S01°30'25"E
L41	294.08	S78°17'03"W
L42	191.43	S88°36'04"W
L43	218.41	N72°29'03"W
L44	236.02	N27°08'31"W
L45	83.91	S26°21'35"W
L46	612.74	S84°41'22"W
L47	88.04	S85°37'03"W
L48	121.48	S38°01'50"W
L49	158.92	S27°57'34"W
L50	168.48	S86°33'47"W
L51	447.02	S30°06'30"W
L52	309.28	S17°07'34"W
L53	272.04	S32°50'15"E
L54	191.18	S12°40'55"E
L55	848.67	N00°08'57"W
L56	144.42	N27°40'45"E
L57	136.02	S09°34'22"E
L58	355.30	S12°10'42"W
L59	378.36	S13°45'14"E
L60	250.54	S19°41'07"E
L61	227.06	S17°16'41"W
L62	214.08	S17°37'38"W
L63	411.40	S02°57'20"E
L64	154.85	S27°15'33"E
L65	227.91	S18°23'44"E
L66	204.23	S17°08'37"E
L67	135.25	S40°35'07"W
L68	153.64	S26°45'08"W
L69	219.24	S07°10'26"W
L70	770.28	N07°46'35"W
L71	44.99	N7°44'24"W
L72	40.91	S83°42'13"W
L73	53.27	N82°36'18"W
L74	44.41	S25°31'44"W
L75	162.89	S13°35'13"E
L76	88.09	S06°44'57"W
L77	78.08	N82°07'39"E
L78	116.53	N05°39'50"E
L79	381.57	N17°57'40"W
L80	179.23	N02°46'35"W
L81	179.23	N02°55'15"W
L82	139.86	N47°00'11"W
L83	113.91	N28°10'24"W
L84	195.06	N16°14'13"W
L85	148.23	N09°20'23"W
L86	77.63	N13°46'22"W
L87	400.56	N12°38'18"E
L88	69.62	N45°58'52"E
L89	102.89	N45°40'06"W
L90	151.75	S83°05'27"E
L91	51.02	S84°50'00"E

LINE TABLE		
LINE	LENGTH	BEARING
L92	170.03	S07°42'16"E
L93	247.44	S00°35'39"W
L94	110.72	S26°13'47"E
L95	77.65	S38°53'21"E
L96	1171.77	S38°53'21"E
L97	384.03	S70°28'59"E
L98	71.09	S25°31'57"E
L99	99.29	S33°38'37"E
L100	211.20	N05°44'17"E
L101	109.26	N07°46'51"E
L102	99.38	N69°16'10"E
L103	96.19	N16°39'35"E
L104	88.48	N32°52'46"E
L105	126.01	N83°40'37"E
L106	222.44	N16°12'41"W
L107	175.35	N30°55'47"W
L108	55.56	N19°16'39"W
L109	128.64	N19°43'28"E
L110	515.83	S75°20'13"E
L111	582.28	S73°56'22"E
L112	170.58	S71°50'37"E
L113	87.51	S80°22'41"E
L114	144.19	N78°30'37"E
L115	287.40	N83°15'01"E
L116	140.39	N79°55'22"E
L117	135.21	S46°31'53"E
L118	180.71	S74°41'32"E
L119	272.88	N84°28'08"E
L120	232.17	N71°01'37"E
L121	133.31	N61°46'54"E
L122	132.21	N51°03'44"E
L123	116.63	N45°14'13"E
L124	280.56	N35°11'03"E
L125	187.32	N46°51'22"E
L126	84.42	N24°18'12"E
L127	129.04	N65°55'20"E
L128	586.10	N23°09'01"W
L129	180.92	N06°36'28"W
L130	122.94	N07°45'03"E
L131	144.54	N31°33'35"E
L132	843.28	N65°15'57"E
L133	287.08	N80°33'45"E
L134	250.04	N81°20'32"E
L135	288.48	N45°52'06"E
L136	237.89	S47°20'02"E
L137	223.58	S25°31'28"E
L138	253.66	N41°10'02"E
L139	253.66	N89°23'02"E
L140	216.89	S47°20'02"E
L141	126.74	S50°10'33"E
L142	350.95	S80°20'59"E
L143	240.89	S29°46'37"E
L144	406.63	S70°40'50"E
L145	145.12	S47°52'47"E
L146	144.69	N13°05'36"E
L147	127.61	N27°40'45"E
L148	136.02	N66°36'03"E
L149	65.44	N85°29'58"E
L150	104.88	N61°16'40"E
L151	47.05	N08°38'38"W
L152	456.74	N40°13'59"E
L153	391.95	N26°53'30"E
L154	288.39	N40°13'59"E
L155	585.82	N43°56'45"E
L156	280.27	N31°39'53"E
L157	233.08	N84°56'03"E
L158	451.72	N64°56'03"E
L159	283.52	N07°05'08"E
L160	197.43	N87°15'17"W
L161	16.72	N11°59'34"E
L162	929.07	N00°08'57"W
L163	285.31	N21°32'48"W
L164	171.35	N29°27'10"E
L165	283.39	N21°11'45"W
L166	81.78	N33°22'41"W
L167	295.25	N23°45'41"W
L168	147.52	N64°57'17"W
L169	83.87	N57°15'42"W
L170	349.23	N60°58'21"W
L171	386.17	N13°02'01"E
L172	257.61	N19°07'56"E
L173	94.73	S19°46'47"E
L174	321.51	S46°59'20"E
L175	126.04	S14°13'47"E
L176	83.31	S85°41'32"E
L177	190.25	S84°04'28"E
L178	160.60	N75°30'57"E
L179	214.60	N82°09'04"E
L180	179.64	S81°38'05"E
L181	140.05	S44°21'43"E
L182	99.90	N73°12'55"E

LINE TABLE		
LINE	LENGTH	BEARING
L183	158.56	N27°18'12"E
L184	201.19	N34°58'48"E
L185	293.67	N16°25'04"E
L186	73.26	N62°29'32"E
L187	359.66	N67°42'30"E
L188	280.56	N43°08'56"W
L189	64.25	N44°30'04"W
L190	61.98	S29°57'46"E
L191	93.40	N88°12'55"E
L192	278.48	N23°51'41"W
L193	89.45	N27°23'11"W
L194	419.67	N19°33'22"W
L195	403.73	N24°55'48"W
L196	186.42	N19°07'22"W
L197	181.03	N24°03'33"W
L198	151.63	N27°46'49"W
L199	248.25	N14°49'26"W
L200	324.49	N22°42'25"W
L201	142.57	N19°44'37"W
L202	INTENTIONALLY OMITTED	
L203	82.82	N60°54'59"W
L204	101.85	N03°19'14"W
L205	257.33	N04°35'51"E
L206	131.11	N00°55'54"W
L207	112.17	N06°54'42"W
L208	155.85	N05°41'41"W
L209	219.93	N20°27'23"W
L210	166.03	N80°04'10"E
L211	38.90	N23°02'05"E
L212	86.29	S47°00'44"E
L213	168.90	S50°09'23"E
L214	143.11	S26°19'17"E
L215	81.14	N79°41'02"E
L216	150.88	N7°32'28"E
L217	133.63	S39°45'17"E
L218	58.44	S17°16'00"E
L219	42.03	S39°58'41"E
L220	212.33	S80°07'07"E
L221	146.05	S70°48'16"E
L222	234.89	S84°00'53"E
L223	88.46	S94°05'57"E
L224	166.50	N16°32'49"W
L225	223.02	N03°04'30"E
L226	488.87	N49°46'28"E
L227	92.68	N30°23'02"E
L228	105.43	N12°56'40"E
L229	188.34	N17°39'53"W
L230	161.54	S87°07'57"W
L231	224.43	S74°37'41"W
L232	146.05	N14°29'06"W
L233	101.81	S46°29'19"W
L234	47.54	N34°02'59"W
L235	57.03	N55°43'50"W
L236	48.24	N30°38'23"W
L237	161.54	S87°07'57"W
L238	224.43	S74°37'41"W
L239	109.06	N86°11'23"W
L240	72.01	S82°07'57"E
L241	113.24	N28°47'44"W
L242	198.34	N04°06'02"W
L243	37.84	N02°58'11"E
L244	163.54	N02°58'11"E
L245	123.27	N64°09'45"E
L246	46.55	S57°28'04"E
L247	91.57	S55°42'03"E
L248	168.40	S81°45'40"E
L249	374.19	S25°25'48"E
L250	146.97	S06°56'34"E
L251	73.81	N49°43'15"E
L252	247.86	N78°32'26"E
L253	202.94	S12°46'07"E
L254	86.35	S17°32'40"E
L255	100.32	S26°57'00"E
L256	144.03	S17°00'35"E
L257	388.43	S10°42'31"E
L258	285.86	S25°01'39"E
L259	206.66	S35°15'13"E
L260	174.30	S44°40'15"E
L261	98.14	S09°33'55"E
L262	148.55	S47°38'27"E
L263	187.36	S80°26'33"E
L264	112.27	S89°44'39"E
L265	121.18	S72°40'42"E
L266	70.38	S14°13'47"E
L267	37.98	S46°36'28"E
L268	61.49	S54°09'52"E
L269	43.40	S26°28'41"E
L270	159.69	S90°43'13"E
L271	40.05	S05°07'14"W
L272	80.39	N00°08'37"W
L273	20.25	N02°04'46"W

LINE TABLE		
LINE	LENGTH	BEARING
L274	12.55	S09°27'13"W
L275	198.18	S86°10'45"E
L276	73.26	S84°52'19"E
L277	73.25	S87°28'30"E
L278	65.07	S76°34'17"E
L279	110.79	S38°27'17"E
L280	146.24	S27°10'48"E
L281	238.02	S02°34'53"W
L282	54.13	S02°34'53"W
L283	86.56	S32°35'32"E
L284	118.11	S02°40'13"E
L285	146.87	S40°23'29"W
L286	98.03	S47°05'28"E
L287	54.92	S14°10'50"E
L288	110.79	S57°49'04"E
L289	73.33	S57°49'04"E
L290	374.12	N02°34'13"W
L291	104.06	N02°49'28"E
L292	190.00	N16°53'52"E
L293	380.31	N16°26'34"W
L294	182.05	N07°12'20"W
L295	281.22	N62°31'33"W
L296	128.70	S84°31'34"E
L297	131.11	N05°45'30"W
L298	348.83	N52°45'31"W
L299	170.19	N62°24'51"W
L299	148.30	N72°20'00"W
L300	105.16	N54°57'23"W
L301	156.03	S73°16'27"E
L302	218.25	N59°08'37"W
L303	180.58	N57°24'27"W
L304	106.16	N58°15'26"W
L305	238.68	N80°26'17"E
L306	141.75	N79°41'02"E
L307	219.47	N22°50'32"E
L308	317.96	N27°46'42"W
L309	786.48	N02°30'47"W
L310	177.18	N02°04'27"W
L311	25.91	S70°40'50"W
L312	119.27	S70°40'50"W
L313	113.60	S80°25'05"E
L314	123.98	S86°25'05"E
L315	140.96	S76°17'03"W
L316	153.12	S76°17'03"W
L317	101.63	N14°32'54"W
L318	10.25	N14°32'54"W
L319	101.63	S87°07'57"W
L320	67.18	S80°09'23"E
L321	92.70	N07°46'03"E
L322	30.24	N07°46'03"E
L323	52.47	S31°10'26"E
L324	73.68	S31°10'26"E
L325	117.18	S71°50'37"E
L326	58.80	S71°50'37"E