NARRATIVE:
THE PURPOSE OF THIS SURVEY WAS TO ESTABLISH A PORTION OF LONGVIEW TIMBERLANDS
LLC PROPERTY BOUNDARY AS SHOWN FOR FUTURE LOGGING PURPOSES.
FOR THIS SURVEY I ESTABLISHED STATIC PAIRS NEAR THE EAST QUARTER CORNER AND
NORTHEAST CORNER OF THE SECTION. RANDOM CLOSED LOOP TRAVERSES WERE RAN ALONG THE
LINES SHOWN. ALL MONUMENTS SHOWN AS FOUND OR SET WERE DONE SO RADIALLY FROM SAID
TRAVERSES.

THE MONUMENTS SHOWN AS SET WERE PART OF THE "BOISE CASCADE SHORT PLAT" (SURVEY REFERENCE 3). A SEARCH WAS MADE FOR THE MONUMENTS SET DURING SAID SHORT PLAT BUT I WAS UNABLE TO FIND ANY EVIDENCE OF THEM. THEREFOR I HELD DEED ANGLES AND DISTANCES AND SET NEW MONUMENTS PER THE LEGEND.

25 N 01"14'32" E [2728.32' SR1] 1364.16' CALCULATED POSITION OF CENTER OF SECTION PER ROS 3-202 1364.16 CTION WITH
DATA PER ROS BEHIND LONGVIEW TIMBERLANDS LLC AF# 2007166332 89°28'42" E THE GATE LLC " HEMLOCK SCRIBED "NE BT" BEARS I BEARS I FOUND AND HELD 5/8 ...
PER ROS 3-202 WIT
FOLLOWING EXISTING REFER!
21" HEM N60"W FIR SCRIBED NE 1/16 CO FOUND PIPE MTH PIPE EXISTING REFERE HEMLOCK STUMP S72'W FIR STUMP N25'E NEW REFERE 1318.91 SET AT RECORD/DEED DISTANCE ON LINE 20" HEM 15" HEM D A PIPE W D PER 1970 SURVEY 89"31"52" E N 0244'41" E 1367.06' 966.06 N 02°12'09" E 1365.87' [401.00'] 1225.87 SET AT RECORD/DEED DISTANCE ON LINE BETWEEN MONUMENTS FOUND AS NOTED [2683.64' SR1] [140.00] FOUND DNR MON PER ROS 3-202.

EXISTING REFERENCES:

(OBT) 38" HEM STUMP N63'E 23.96'

(OBT) 42" HEM STUMP S58'E 43.72'

(OBT) 20" HEM STUMP S13'W 43.40'

(OBT) 38" CEDAR STUMP N62'W 49.30'

(OBT) 38" CEDAR STUMP N62'W 49.30'

13" HEMLOCK WITH DNR TAG S37'E 6.95'

NEW REFERENCES:

NEW REFERENCES LONGVIEW TIMBERLANDS LLC AF# 2007166332 LONGVIEW TIMBERLANDS LLC AF# 2007166332 1294.83 FOUND AND HELD DNR CONCRETE MONUMENT AS NOTED IN ROS 3-202 S 02°12'09" W [632.00'] - HELD LINE PARALLEL WITH THE WEST LINE OF THE NE 1/4 OF THE NE 1/4 PER DEED 1317.81 25 RANGE 5 EAST 1369.18 RANGE 6 EAST 30 S 0312'15" W 2738.35' [2738.11' SR1] 1369.18'

AUDITOR'S ERTIFICATE

FOR RECORD THIS REQUEST OF I DAY OF July

20 /3

Ą

JOB NO.

LONGVIEW TIMBER CORPORATION. AF DEPUTY COUNTY AUDITOR 3 AT PAGE / 201300 1459

DRAWN BY:

CALC BY:


CHECKED BY:

A FIELD TRAVERSE WAS PERFORMED USING A NIKON NIVO 3.0C THREE SECOND TOTAL STATION WITH TDS DATA COLLECTION SYSTEM. THE FIELD TRAVERSE MET THE MINIMUM STANDARDS FOR SURVEYS AS DESIGNATED IN WAC 332-130-090. ALL CORNERS NOTED AS FOUND WERE VISITED IN MAY 2013.

LONGVIEW TIMBER CORPORATION MAKES NO WARRANTIES AS TO MATTERS OF UNWRITTEN TITLE SUCH AS ADVERSE POSSESSION, ACQUIESCENCE, ESTOPPLE,

## RECORD SURVEY

SKAMANIA NE NE Z A PORTION /4 OF T2., NC. A COUNTY, AND JUNE 21, SE SEC1 2013 TION W.M. 4 유 WASHINGTON 유 25 HE HE ZE

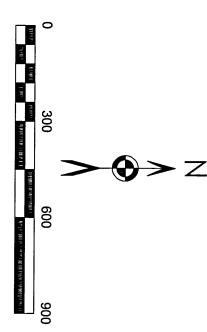

BASIS OF BEARING: NAD 83/12, WSPCS, SOUTH ZONE, US SURVEY FEET. S 03°12'15" W ALONG THE EAST LINE OF THE NE 1/4 OF SECTION 25 BETWEEN MONUMENTS FOUND AS NOTED. DISTANCES SHOWN HEREON ARE GROUND.

## LEGEND:

INDICATES CALCULATED POSITION

0

- INDICATES MONUMENT FOUND AS NOTED
- INDICATES  $5/8" \times 36"$  IRON REBAR WITH YELLOW PLASTIC CAP INSCRIBED "SIMES 44648" SET

 $\odot$ 

- INDICATES RECORD INFORMATION PER SURVEY REFERENCE NUMBER
- INDICATES DEED INFORMATION
- INDICATES SURVEY REFERENCE NUMBER

SR1


INDICATES LINE MARKED WITH  $1/2^{"}\times72"$  FIBER GLASS RODS WITH RED AND WHITE RIBBON. TREES ALONG LINE PAINTED AND BLAZED WITH BLUE PAINT.

SURVEY REFERENCE:

1) D. SIMES SURVEY, BOOK 3 PAGE 202

2) REYNOLDS UNRECORDED SURVEY
DATED MAY 23, 1970 FOR TAYLOR
LUMBER CO. & CROWN ZELLERBACH


3) BOISE CASCADE SHORT PLAT, BOOK
3 OF SHORT PLATS, PAGE 22

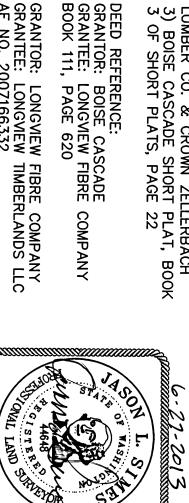

GRANTOR: LONGVIEW FIBRE COMPANY GRANTEE: LONGVIEW TIMBERLANDS LLC AF NO. 2007166332

SURVEYOR'S CERTIFICATE

THIS MAP CORRECTLY REPRESENTS A SURVEY MADE BY ME OR UNDER MY DIRECTION IN CONFORMANCE WITH THE REQUIREMENTS OF THE SURVEY RECORDING ACT AT THE REQUEST OF \_\_\_\_\_\_ LONGVIEW TIMBER \_\_\_\_\_\_ IN \_\_\_\_\_JUNE \_\_\_\_\_\_ 2013.

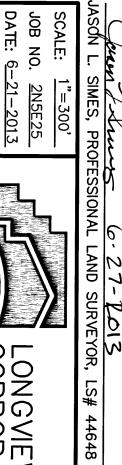

SCALE:

LONGVIEW TIME
CORPORATION
10 INTERNATIONAL
LONGVIEW, WA 98 TIMBER AL WAY 98632

STL STF EVB