AFN #2018002117 Recorded Oct 17, 2018 03:26 PM DocType: SURV Filed by: AKS Engineering & Forestry, LLC Page: 1 of 1 File Fee: \$183.00 Auditor Robert J. Waymire Skamania County, WA


## RECORD OF SURVEY


LOCATED IN THE SW 1/4 OF THE NW 1/4 OF SECTION 34, TOWNSHIP 2 NORTH, RANGE 5 EAST, WILLAMETTE MERIDIAN, SKAMANIA COUNTY, WASHINGTON OCTOBER 9, 2018

#### **NARRATIVE**

THE PURPOSE OF THIS SURVEY IS TO CALCULATE AND MONUMENT THE CITED SOLLARS/MEZA TRACT AS SHOWN. A PORTION OF THIS TRACT AS WELL AS ADJOINING TRACTS TO THE WEST AND EAST OF THE SOLLARS/MEZA TRACT WERE PREVIOUSLY MONUMENTED IN BOOK 3, PAGE 133, SKAMANIA COUNTY RECORDS. IN SAID SURVEY. TO ESTABLISH THE BOUNDARY AS SHOWN IN THIS SURVEY A MATHEMATICAL MODEL WAS CREATED FROM SAID SURVEY. A CONTROL TRAVERSE THAT MET THE STANDARDS CONTAINED IN WAC 332-130-090 WAS RUN BETWEEN FOUND MONUMENTS DESIGNATED AS POINTS A AND B AS SHOWN AND ROTATED TO THE MATHEMATICAL BEARING OF NORTH 83'20'39" EAST PER SAID SURVEY. OTHER TIED MONUMENTS CHECKED SATISFACTORY WITH MODELED POSITIONS AS SHOWN. A 3-SECOND TOTAL STATION INSTRUMENT WITH ELECTRONIC DATA COLLECTOR WAS USED FOR ALL FIELD WORK. NEW CORNERS ESTABLISHED IN THIS SURVEY WERE SET BY RADIAL STAKEOUT FROM THE ABOVE MENTIONED TRAVERSE.

# TREE-IFIC DRIVE WEST

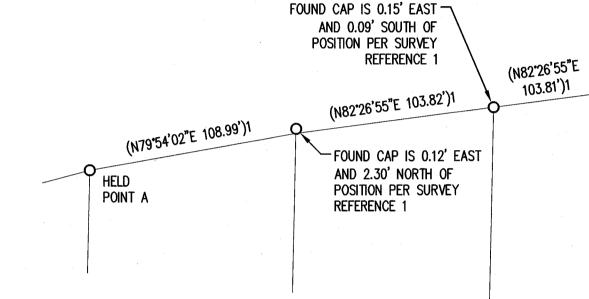

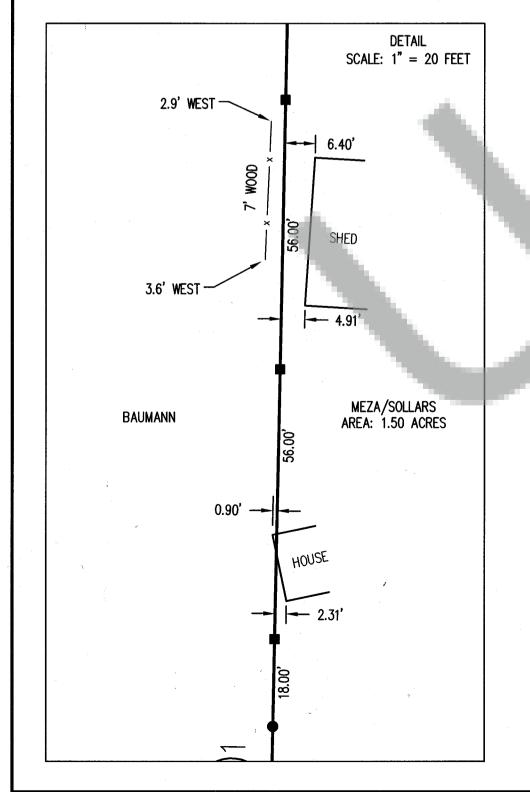

### (N85"12'07"E)1 47.39 (N82°26'55"E (N8512'07"E 100.68')1 POINT B 103.81')1 HELD JONES AFN 131744 SEE DETAIL MEZA/SOLLARS AFN 2016002528 — PER AGREEMENT IN AFN 131744 AREA: 1.50 ACRES (BOOK 177 AT PAGE 771) BAUMANN AFN 2013002625 AND 2015000756 - PER AGREEMENT IN AFN 131744 (BOOK 177 AT PAGE 771). FOUND PIPE IS 0.29' WEST AND 0.13' SOUTH OF AGREED POSITION (NOT HELD) WASHOUGAL RIVER

#### **LEGEND**

- SET (ON-LINE) 5/8" X 30" IRON ROD WITH AN ORANGE PLASTIC CAP INSCRIBED "AKS ENGR 34127"
- SET (ON-LINE) 2" X 2" WOODEN HUB WITH TACK
- FOUND 2-1/2" BRONZE CAP INSCRIBED "LAWSON 11989" AS SHOWN IN ROS 3-133 (TIED ON 29 AUGUST 2018); HELD UNLESS NOTED OTHERWISE
- POSITION OF 5/8" IRON ROD WITH AN ORANGE PLASTIC CAP INSCRIBED "51797" PER ROS AFN 2015000797
- FOUND 1" IRON PIPE PER AFN 131744 (TIED ON 29 AUGUST 2018); HELD UNLESS NOTED OTHERWISE
- 1/2" IRON PIPE AS SHOWN IN ROS 3-133
- AUDITOR'S FILE NUMBER
- RECORD OF SURVEY
- HELD RECORD DATA PER SURVEY REFERENCE 1

### **AUDITOR'S CERTIFICATE**


FILED FOR RECORD THIS 17-10	_ DAY OF
OCTOBER	, 2018 AT
	OF
SURVEYS AT PAGE AT THE RE	equest of
SURVEYS AT PAGE AT THE RI AKS ENGINEERING & FORESTRY. AFN 2	£11.6008107
Marcha Diana	

V DUNK V DERIGUER DEPUTY COUNTY AUDITOR


SURVEYOR'S CERTIFICATE THIS MAP CORRECTLY REPRESENTS A SURVEY MADE BY ME OR UNDER MY DIRECTION IN CONFORMANCE WITH THE REQUIREMENTS OF THE SURVEY RECORDING ACT AT THE REQUEST OF MARIA MEZA IN SEPTEMBER, 2018.


PROFESSIONAL LAND SURVEYOR LICENSE NO. 34127

10/9/2018

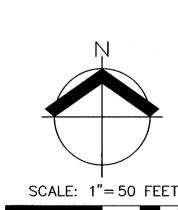



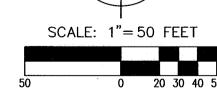

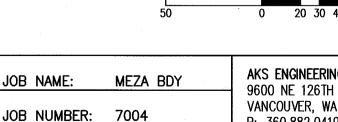

JOB NAME:

DRAWN BY:

CHECKED BY: CAB

DRAWING NO.: 7004ROS

KLT

AKS ENGINEERING & FORESTRY, LLC 9600 NE 126TH AVE STE 2520 VANCOUVER, WA 98682 P: 360.882.0419 F: 360.882.0426 aks-eng.com



**ENGINEERING · SURVEYING · NATURAL RESOURCES** FORESTRY · PLANNING · LANDSCAPE ARCHITECTURE

#### DEED REFERENCE **SURVEY REFERENCES**

(S8777'19"W 66.88')1 (S8075'15"W)1 88.00'

- RECORD DATA PER SURVEY BOOK 03 PAGE 133
- RECORD DATA PER SURVEY BOOK 02 PAGE 244 RECORD DATA PER SURVEY BOOK 03 PAGE 166
- RECORD DATA PER SURVEY AFN 2015000797 RECORD SURVEY DATA PER VESTING DEED AFN 2016002528
- STATUTORY WARRANTY DEED JAY AND KATHY ELLIS

ANTHONY SOLLARS AND MARIA MEZA AFN: 2016002525 (12-1-2016)