

4397

## EASEMENT AMENDMENT

This Easement and Amendment is made and entered into by and between the STATE OF WASHINGTON, acting by and through the Department of Natural Resources, herein called the "State," and LONGVIEW FIBRE COMPANY, a Delaware corporation, herein called "Longview Fibre," with reference to the following facts:

- A. On October 5, 1977, Longview Fibre and the State entered into a certain Easement which was recorded in the records of Skamania County under Skamania County Auditor's File No. 85077 in Volume 74:1 Deeds, Pages 635 - 639.
- B. The State and Longview Fibre desire hereby to amend the Easement so as to delete a certain road therefrom.

NOW THEREFORE, the State and Longview Fibre mutually agree as follows:

1. There is hereby deleted from the Easement above described that certain road as shown in red on the attached Exhibit A, over and across portions of the NW&NW& of Section 3, Township 2 North, Range 7 East, W.M.
2. Except as herein expressly amended, the Original Easement is hereby confirmed and ratified and remains in full force and effect.

IN WITNESS WHEREOF, the parties hereto have executed this instrument, in duplicate as of the day and year first above written.

LONGVIEW FIBRE COMPANY

W. LEE A.  
VICE PRESIDENT  
Title

By W. Lee A. Johnson  
Attest: John C. Cole  
Title

Affix Seal of Corporation

Affix Seal of Commissioner  
of Public Lands

Easement No. 1603

ee

*Longview Fibre Co.**Longview Fibre Co.*

APPROVED  
JUN 23 1978  
DATE  
6-5-78  
S-11

STATE OF WASHINGTON  
DEPARTMENT OF NATURAL RESOURCES  
By Bert L. Cole  
BERT L. COLE  
Commissioner of Public Lands

No. 3021  
TRANSACTION EXCISE TAX

JUN 23 1978  
Amount Due Exempt

Skamania County Treasurer  
By Longview Fibre Co.

STATE OF WASHINGTON )  
County of Cowlitz ) ss

On this 30th day of May, 1978, before me personally appeared W. L. Robinson  
and G. E. Schwartz, to me known to be  
the Vice President-Timber and Secretary, respectively, of Longview Fibre Company,  
the corporation that executed the within and foregoing instrument, and acknowledged  
said instrument to be the free and voluntary act and deed of said corporation, for  
the uses and purposes therein mentioned, and on oath stated that they were authorized  
to execute said instrument and that the seal affixed is the corporate seal of said  
corporation.

IN WITNESS WHEREOF, I have hereunto set my hand and affixed my official seal the  
day and year first above written.

Notary Public in and for the State of Washington, residing at Kelso

STATE OF WASHINGTON )  
COUNTY OF THURSTON ) ss

On this 15th day of May, 1978, before me personally appeared  
BERT L. COLE, to me known to be the Commissioner of Public Lands, and ex officio  
Administrator of the Department of Natural Resources of the State of Washington, the  
Department that executed the within and foregoing instrument, behalf of the State  
of Washington, and acknowledged said instrument to be the free and voluntary act and  
deed of the State of Washington for the uses and purposes therein mentioned, and on  
oath stated that he was authorized to execute said instrument and that the seal affixed  
is the official seal of the Commissioner of Public Lands for the State of Washington.

IN WITNESS WHEREOF, I have hereunto set my hand and seal the day and year set  
forth above.

Notary Public in and for the State of Washington, residing at Olympia.

STATE OF WASHINGTON  
DEPARTMENT OF NATURAL RESOURCES  
REPT L. COLE, Comptroller of Public Lands

BOOK 25 PAGE 72


Application No.

County. SKAMANIA

Name of Sale

District

TOWNSHIP 2 NORTH, RANGE 7 (E) W.M.

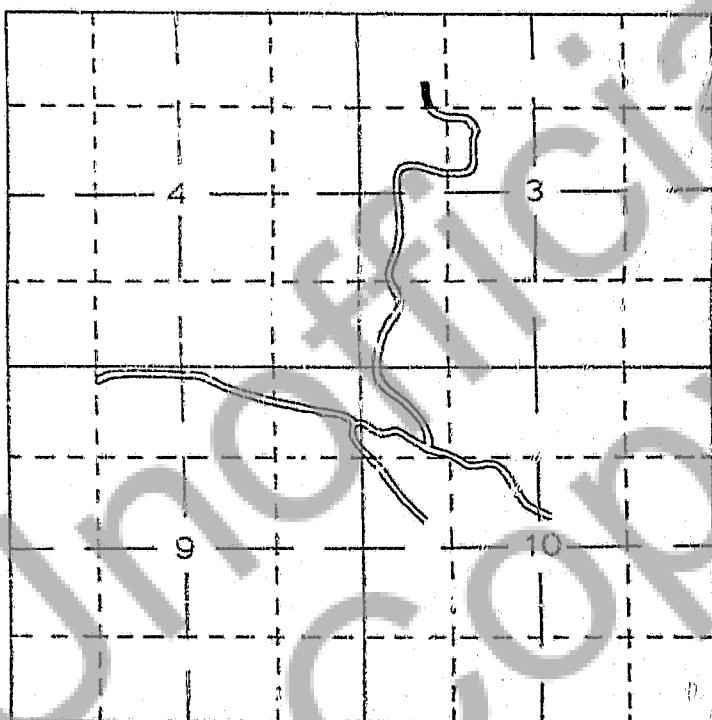

**EXHIBIT 'A'**

SCALE: 1 = 2000'

LEGEND

Drawn By:

Date: